

3 13T

Neshoba
B4
10-67

MISSISSIPPI
BOARD OF WATER COMMISSIONERS
416 North State Street
Jackson, Mississippi 39201

CODED

WATER WELL DRILLERS LOG

19 OGLETREE DRILLING NESHOPA
date well completed firm name county well located

LANDOWNER: GROVER WILLIS
RT. 8

PHILADELPHIA, MISS.
(mailing address)

WELL LOCATION:
sec. 28 T. 12 S. R. 11 E.
6 miles North of Phila.
(distance) (direction) (nearest town)

WELL PURPOSE: HOME AND INDUSTRIAL
(home, irrigation, municipal, industrial)

WELL COMPLETION DATA:


- (1) diameter (inches) 4"
- (2) total depth (feet) 210
- (3) static water level (feet) 65 ^{below} _{above} top of ground.
- (4) casing Steel, 147,
(material) (depth)
 if telescope see back.
(size)
- (5) screen 15', 210-195
(length) (depth to top)
2" STAINLESS STEEL
(size) (material)
- (6) pump 1 30
(HP) (yield gpm)
REA
(type power)
- (7) electric log NO
(yes or no)

(organization running log)
- (8) how well bottom plugged POINTED

| description of formations encountered | from | to |
|---------------------------------------|----------|-----|
| | RED CLAY | 0 |
| RED SAND | 30 | 60 |
| BLUE CHALK | 60 | 175 |
| WHITE SAND | 175 | 210 |

CODED


DRILLERS REMARKS:

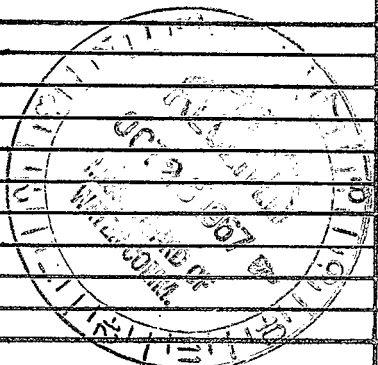

If well telescopes please sketch and show depths.

GROUND LEVEL

4"
147'

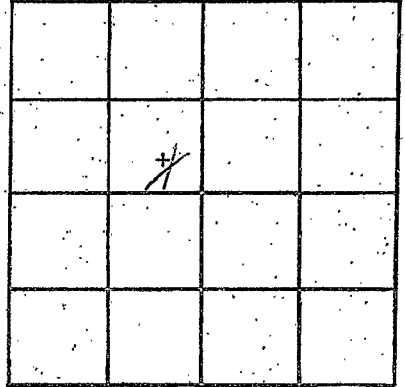

SECTION 28

Please indicate well location X.

ADDITIONAL INFORMATION

48'
2" CASSIN

15'
JOHNSON
STAINLESS
STEEL POINT

If more than one screen,
show locations of each on sketch.