

B5

WATER WELL DRILLERS LOG CODED

10-1-60

Date: 10-1, 1960, Driller: M. L. King County Neshoba

(1) Owner of Land: Charles Adams
 (Name)
Phillips Mass Rd
 (Address)

(2) Location: 1/4, 1/4, Sec. 29 T.12. R.11
12 miles W of Phila
 (distance) (direction) (Nearest Town)

(3) Topography: Hilly
 (Hilly) (Flat) (Level)

(4) Purpose of Well: Domestic
 (Domestic Irrigation
 Municipal, Industrial, Other)

Description & Color of Materials Sand, Clay, Red Clay, Shell, etc.	Thick- ness Feet	Depth Feet
Clay 0-12	12	0-12
Red sand 12-25	25	12-25
Blue clay 25-30	5	25-30
Loose sand 30-40	10	30-40
Gravel sand 40-105	65	40-105

Information upon completion of well:

(1) Diameter 2 inches.

(2) Total Depth 105 feet.

(3) Water Level 40 feet below top of ground.

(4) Cased to 63 ft, Size 2


(5) Screen: Size Open, Length _____

(6) Were any formations sealed against pollution?
 _____ yes, no.

If YES depth of formation _____

Why _____

Drillers Remarks: _____

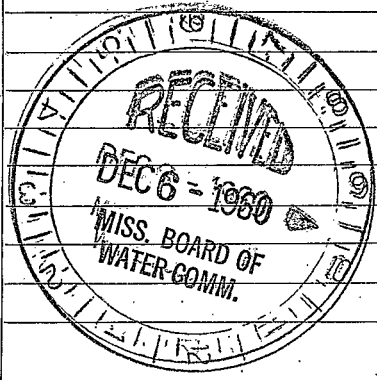

(Use Back Side)

Well No.

