

NEESHABA
B-1
1-3-61

MISSISSIPPI BOARD OF WATER COMMISSIONERS

6 137

WATER WELL DRILLERS LOG

Date: 1-3, 1961, Driller: Hester Ogletho County Neshoba
(Name)

(1) Owner of Land: Robert Ingram
(Name)

(Address) 30 12 11

(2) Location: 1/4, 30 12 11, 1/4, Sec. T, R
12 miles north, of phila.
(distance) (direction) (Nearest Town)

(3) Topography: level
(Hilly) (Flat) (Level)

(4) Purpose of Well:
(Domestic Irrigation
Municipal, Industrial, Other)

Description & Color of Materials Sand, Clay, Red Clay, Shell, etc.	Thick- ness Feet	Depth Feet
<u>0-40 ft. sandy clay</u>		
<u>10-97 ft. blue clay</u>		
<u>30 ft. water sand</u>		
<u>37-167</u>		

Information upon completion of well:


- (1) Diameter 4 1/4 inches.
- (2) Total Depth 167 feet.
- (3) Water Level 28 feet below top of ground.
- (4) Cased to 105, Size 2 in.
- (5) Screen: Size _____, Length _____.
- (6) Were any formations sealed against pollution?
_____ yes, _____ no.

If YES depth of formation _____

Why _____

Drillers Remarks: _____

CODED

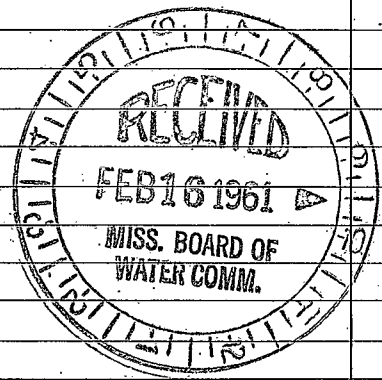

(Use Back Side)

Well No.

