

Q B 8


WATER WELL DRILLERS LOG

6-21-61 CODED

Date: 6/21, 19 61, Driller: Hester Dykstra County Neshoba

	Description & Color of Materials Sand, Clay, Red Clay, Shell, etc.	Thick- ness Feet	Depth Feet
(1) Owner of Land: J. C. Smith (Name) Route 6 Philadelphia Miss (Address)	103 sand		
(2) Location: 1/4, 1/4 Sec. 15 12 11 9 miles north, of Philadelphia (distance) (direction) (Nearest Town)			
(3) Topography: Hilly (Hilly) (Flat) (Level)			
(4) Purpose of Well: Home use (Domestic Irrigation Municipal, Industrial, Other)			
Information upon completion of well:			
(1) Diameter 4 inches.			
(2) Total Depth 103 feet.			
(3) Water Level 70 feet below top of ground.			
(4) Cased to 97, Size 2 in.			
(5) Screen: Size 1 1/4, Length 6 ft.			
(6) Were any formations sealed against pollution? _____ yes, _____ no.			
If YES depth of formation _____			
Why _____			
Drillers Remarks: _____			Well No.

CODED

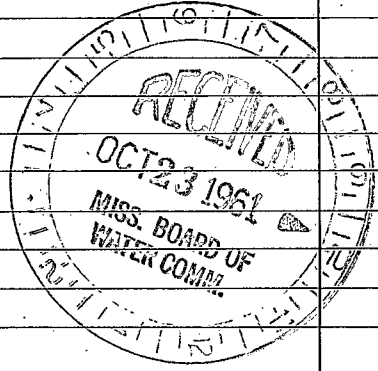

(Use Back Side)

THE HISTORY OF THE

Faint, illegible text covering the majority of the page, appearing as a series of light grey smudges and speckles.