

3 131

MISSISSIPPI
BOARD OF WATER COMMISSIONERS
416 North State Street
Jackson, Mississippi 39201

WATER WELL DRILLERS LOG

Neshoba
B9
10-67 CODED

OCTOBER 12 19 67 OGLETREE DRILLING NESHOBA
date well completed firm name county well located

LANDOWNER: JAMES BENNETT*
PT. 8 PHILADELPHIA, MISS.
(mailing address)

description of formations encountered	from	to
RED CLAY	0	12
BLUE CHALK	12	80
BLUE SAND	80	100

WELL LOCATION:
sec. 34 T 12 N R 11 E
7 miles NORTH of PHILA.
(distance) (direction) (nearest town)

WELL PURPOSE: HOME USE
(home, irrigation, municipal, industrial)

WELL COMPLETION DATA:


- (1) diameter (inches) 2"
- (2) total depth (feet) 100ft.
- (3) static water level (feet) 50 below
top of ground. above
- (4) casing GAV. 958
(material) (depth)

(size) if telescope see back.
- (5) screen 5' 100-95
(length) (depth to top)
1 1/4 STAINLESS STEEL
(size) (material)
- (6) pump 1 6.5
(HP) (yield gpm)

REA
(type power)
- (7) electric log NO
(yes or no)

(organization running log)
- (8) how well bottom plugged POINTED


CODED

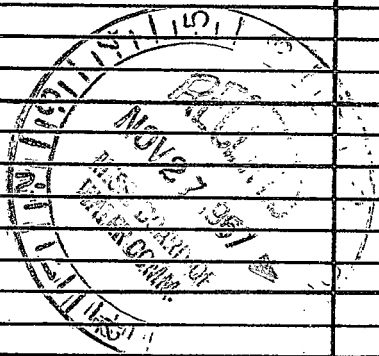

DRILLERS REMARKS:

If well telescopes please sketch and show depths.

GROUND LEVEL

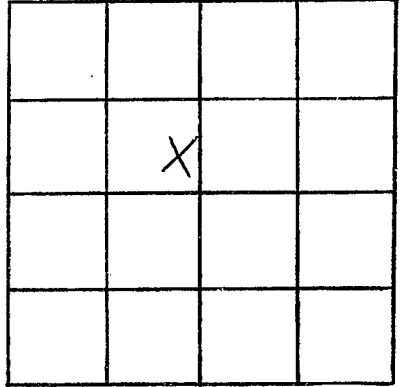

SECTION 34

Please indicate well location X.

ADDITIONAL INFORMATION

If more than one screen,
show locations of each on sketch.