

3 135

Corrected
4/24/68
JFO

NESHABA

B 10

12-67

CODED

MISSISSIPPI
BOARD OF WATER COMMISSIONERS
416 North State Street
Jackson, Mississippi 39201

WATER WELL DRILLERS LOG

Dec. 16 1967¹⁹
date well completed

Beck Smith
firm name
Phila miss

Neshaba
county well located

LANDOWNER:

Melvin Edwards.

Rt 6, Phila, Miss
(mailing address)

description of formations encountered

from

to

Red clay	0	10
blue chalk	10	280
Gray sand	280	284

WELL LOCATION:

sec. 1 T. 12^N R. 11^E
S W
14 miles N of Phila
(distance) (direction) (nearest town)

WELL PURPOSE: home
(home, irrigation, municipal, industrial)

WELL COMPLETION DATA:

- (1) diameter (inches) 2"
- (2) total depth (feet) 284'
- (3) static water level (feet) 100' ^{below} above top of ground.
- (4) casing Galv. 284.
(material) (depth)

_____ If telescope see back.
(size)

- (5) screen open well
(length) (depth to top)

_____ (size) (material)

- (6) pump 1 HP set
(HP) (yield gpm)

elec.
(type power)


- (7) electric log no
(yes or no)

_____ (organization running log)

- (8) how well bottom plugged open
well


DRILLERS REMARKS:

CODED

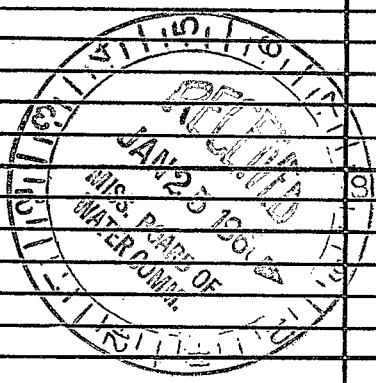

If well telescopes please sketch and show depths.

GROUND LEVEL

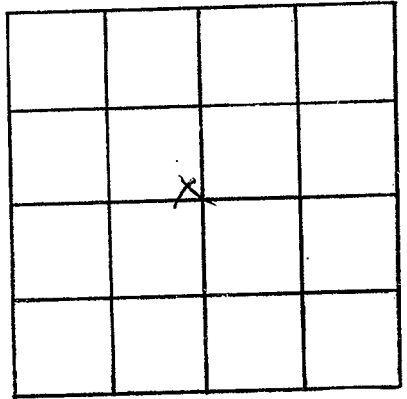

SECTION _____

Please indicate well location X.

ADDITIONAL INFORMATION

If more than one screen, show locations of each on sketch.