

NESHOPA

MISSISSIPPI BOARD OF WATER COMMISSIONERS

WATER WELL DRILLERS LOG

5-29-63 CODED

Date: 5-29, 1963 Driller: M. J. Jay County Neshoba

- (1) Owner of Land: Bill Sistrunk (Name)
Phila. Miss R # 7 (Address)
35 12 11
- (2) Location: 1/4, 1/4, Sec. T R
7 miles North of Phila (distance) (direction) (Nearest Town)
- (3) Topography: (Hilly) (Flat) (Level)
- (4) Purpose of Well: Domestic (Domestic Irrigation, Municipal, Industrial, Other)

Description & Color of Materials
Sand, Clay, Red Clay, Shell, etc.

Thick-
ness
Feet

Dept
Fee

Blue Clay
to 120 ft
Blue sand
150-165 ft

Information upon completion of well:


- (1) Diameter 2 inches.
- (2) Total Depth 168 feet.
- (3) Water Level 48 feet below top of ground.
- (4) Cased to 120, Size 2 in.
- (5) Screen: Size none, Length
- (6) Were any formations sealed against pollution?
yes, no.

CODED

If YES depth of formation

Why

Drillers Remarks:

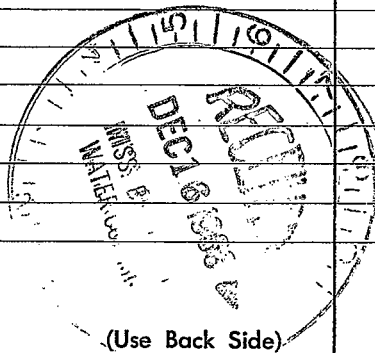

Well No.

