

S 13T

325100 N 0890925

CODED

TETU

Neshoba  
B 12  
8-17-68

MISSISSIPPI  
BOARD OF WATER COMMISSIONERS  
416 North State Street  
Jackson, Mississippi 39201

WATER WELL DRILLERS LOG

8-17-1968 B B Nicholson Neshoba  
date well completed firm name county well located

LANDOWNER: Winford Pope  
Shila.  
Miss.  
(mailing address)


description of formations encountered	from	to
Clay & sand	0	25
mix sand clay	25	40
blue dirt	40	245
mix sand & blue	245	260
water sand	260	270

WELL LOCATION:  
sec. 34 T 12 N R 11 E  
12 miles North of Shila.  
(distance) (direction) (nearest town)

WELL PURPOSE: home  
(home, irrigation, municipal, industrial)


- WELL COMPLETION DATA:
- (1) diameter (inches) 4 1/4
  - (2) total depth (feet) 270
  - (3) static water level (feet) 78 below above top of ground.
  - (4) casing low pipe 260  
(material) (depth)
  - 2" if telescope see back.  
(size)
  - (5) screen 10" 260  
(length) (depth to top)
  - 1 1/4" Steel  
(size) (material)
  - (6) pump H.P. 8  
(HP) (yield gpm)
  - Electric  
(type power)
  - (7) electric log No  
(yes or no)
  - No  
(organization running log)
  - (8) how well bottom plugged Screen

DRILLERS REMARKS:

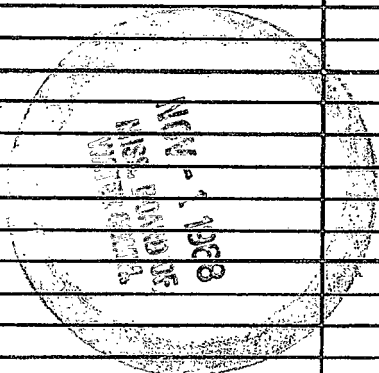

If well telescopes please sketch and show depths.

GROUND LEVEL

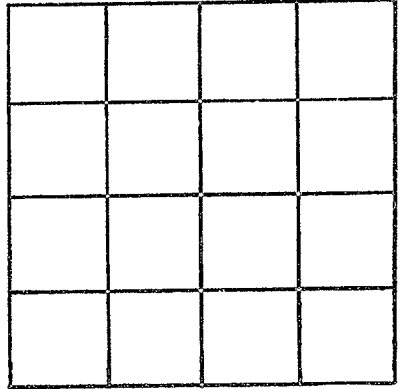

SECTION 34

Please indicate well location X.

ADDITIONAL INFORMATION

If more than one screen,  
show locations of each on sketch.