

Neshoba  
 B 14  
 3-14-70

MISSISSIPPI  
 BOARD OF WATER COMMISSIONERS  
 416 North State Street  
 Jackson, Mississippi 39201

WATER WELL DRILLERS LOG

3-14 1970 Beck Smith Neshoba  
 date well completed firm name county well located

LANDOWNER: BRADY Townsend

description of formations encountered

from

to

Rt 6

phila, Miss  
 (mailing address)

rd clay  
 blue sand

0 20  
 20 35

WELL LOCATION:

sec. 5 T 12 N R 11 W 202

8 1/2 miles NW of phila  
 (distance) (direction) (nearest town)

WELL PURPOSE: home  
 (home, irrigation, municipal, industrial)

WELL COMPLETION DATA:

- (1) diameter (inches) 2"
- (2) total depth (feet) 35'
- (3) static water level (feet) 15' below above top of ground.
- (4) casing galv. 30'  
 (material) (depth)

(size) if telescope see back.

- (5) screen 5' 30'  
 (length) (depth to top)

008, STAINLESS STEEL  
 (size) (material)

- (6) pump 1/2 HP  
 (HP) (yield gpm)

ELEC  
 (type power)

- (7) electric log -  
 (yes or no)

(organization running log)

- (8) how well bottom plugged BACK  
 WASH VALVE


8  
 MAY / 1970

MISS. DD. OF  
 WATER COMMISSIONERS

DRILLERS REMARKS:

If well telescopes please sketch and show depths.

GROUND LEVEL

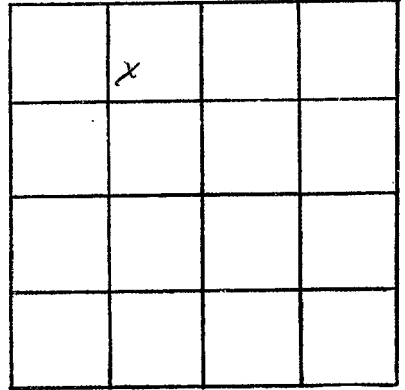

SECTION 5

Please indicate well location X.

ADDITIONAL INFORMATION

If more than one screen,  
show locations of each on sketch.