

MISSISSIPPI BOARD OF WATER COMMISSIONERS

NE 30 BA

B 15

6131 CODED

WATER WELL DRILLERS LOG

CODED

6-21-61

Date: 6/21, 1961, Driller: Hester Ogletree County Neshoba
(Name)

	Description & Color of Materials Sand, Clay, Red Clay, Shell, etc.	Thick- ness Feet	Depth Feet
(1) Owner of Land: <u>R.B. Smith</u> (Name) <u>Route 6 Philadelphia, Miss</u> (Address)	<u>48 ft. sand</u>		
? (2) Location: <u>25</u> <u>1211</u> <u>9</u> miles <u>north</u> , of <u>Philadelphia</u> (distance) (direction) (Nearest Town)			
(3) Topography: <u>Hilly</u> (Hilly) (Flat) (Level)			
(4) Purpose of Well: <u>Home use</u> (Domestic Irrigation Municipal, Industrial, Other)			


Information upon completion of well:

- (1) Diameter 4 inches.
- (2) Total Depth 48 feet.
- (3) Water Level 3.5 feet below top of ground.
- (4) Cased to 42, Size 4 in.
- (5) Screen: Size 1/4, Length 6 ft.
- (6) Were any formations sealed against pollution?
_____ yes, _____ no.

If YES depth of formation _____
Why _____

Drillers Remarks: _____

CODED

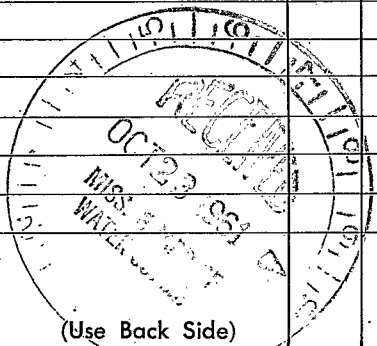

(Use Back Side)

Well No. _____

THE HISTORY OF THE

... ..

... ..

