

MISSISSIPPI DEPARTMENT OF NATURAL RESOURCES

Bureau of Land and Water Resources

Southport Mall

P.O. Box 10631

Jackson, Mississippi 39209

WATER WELL DRILLERS LOG

NESHOPA  
B22

CODED

7-2

1986 Smiths well Drilling

Neshoba

date well completed

firm name

county well located

LANDOWNER: moore

description of formations encountered

from

to

Red sand & clay	0	25
Blue clay	25	160
sand	160	180

(mailing address)

WELL LOCATION:

sec. 5 T. 12 (N) R. 11 (E)  
S W  
12 miles north of Phila  
(distance) (direction) (nearest town)

WELL PURPOSE:

(home, irrigation, municipal, industrial)

WELL COMPLETION DATA:

- (1) diameter (inches) 4
- (2) total depth (feet) 180
- (3) static water level (feet) 80 <sup>below</sup> above top of ground.
- (4) casing PVC 170  
(material) (depth)  
         If telescope see back.  
(size)
- (5) screen 10'± 170  
(length) (depth to top)  
4" PVC  
(size) (material)
- (6) pump 1 22  
(HP) (yield gpm)  
E  
(type power)
- (7) electric log           
(yes or no)  
          
(organization running log)
- (8) how well bottom plugged CAP

CODED


RECEIVED  
AUG 4 1986

Department of Natural Resources  
Bureau of Land & Water Resources

DRILLERS REMARKS:

If well telescopes please sketch and show depths.

GROUND LEVEL

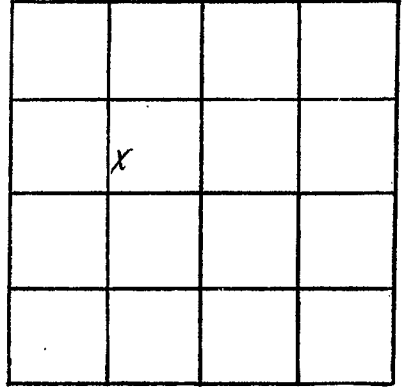

SECTION \_\_\_\_\_

Please indicate well location X.

ADDITIONAL INFORMATION

Lined area for additional information.

If more than one screen, show locations of each on sketch.