

NE SHOBA

B 2001

10-4278

MISSISSIPPI
 BOARD OF WATER COMMISSIONERS
 416 North State Street
 Jackson, Mississippi 39201

WATER WELL DRILLERS LOG

10-4 1978 Beck Smith ne shoba
 date well completed firm name county well located

LANDOWNER:

Johnny Marshall
phila miss
 (mailing address)

description of formations encountered

from to

red clay 0 35
blue cherty 35 80
heavy sand 80 120

WELL LOCATION:

sec. 5 T. 12N R. 11E
~~6~~ miles NW of phila
 (distance) (direction) (nearest town)

WELL PURPOSE: chicken house
(home, irrigation, municipal, industrial)

WELL COMPLETION DATA:

- (1) diameter (inches) 4"
- (2) total depth (feet) 120
- (3) static water level (feet) 50 below above top of ground.
- (4) casing PVC, 100,
 (material) (depth)
 (size) If telescope see back.
- (5) screen 20', 100'
 (length) (depth to top)
8, PVC
 (size) (material)
- (6) pump 1 HP Sub
 (HP) (yield gpm)
elec
 (type power)
- (7) electric log
 (organization running log)
- (8) how well bottom plugged


RECEIVED
 NOV 10 1978

MISS. BD. OF WATER COMMISSIONERS

DRILLERS REMARKS:

If well telescopes please sketch and show depths.

GROUND LEVEL

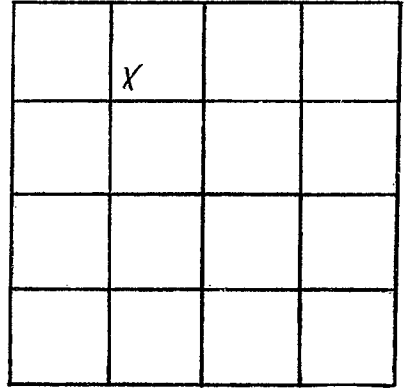

SECTION _____

Please indicate well location X.

ADDITIONAL INFORMATION

If more than one screen,
show locations of each on sketch.