

Neshoba
B 2004
5/14/81

MISSISSIPPI
BOARD OF WATER COMMISSIONERS
416 North State Street
Jackson, Mississippi 39201

WATER WELL DRILLERS LOG

5-14 19 81 Thomas Neshoba
date well completed firm name county well located


LANDOWNER: Robert Bennett
 Hwy 19 W
 Phila. Ms.
(mailing address)

WELL LOCATION:
sec. 27 T. 12 N R. 11 E
S W
5 miles NW of Phila.
(distance) (direction) (nearest town)

WELL PURPOSE: Chicken House
(home, irrigation, municipal, industrial)

- WELL COMPLETION DATA:
- (1) diameter (inches) 4
 - (2) total depth (feet) 260
 - (3) static water level (feet) 80 ^{below} _{above} top of ground.
 - (4) casing PVC, 155
(material) (depth)
4 if telescope see back.
(size)
 - (5) screen open
(length) (depth to top)
(size) (material)
 - (6) pump 3/4 15
(HP) (yield gpm)
2 hp
(type power)
 - (7) electric log NO
(yes or no)
(organization running log)
 - (8) how well bottom plugged open


description of formations encountered	from	to
Dirt	0	10
Pink Chalk	10	25
Chalk & silt sand	25	100
Mostly Chalk w/ fine sand	100	130
Soft Grey Chalk	130	153
Black dirt	153	185
Green sand	185	207
Mottly Chalk	207	260
Blue & Grey w/ little strk Green sand		

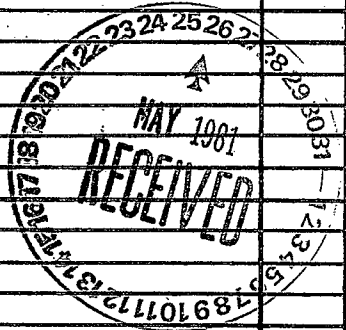

DRILLERS REMARKS:

If well telescopes please sketch and show depths.

GROUND LEVEL

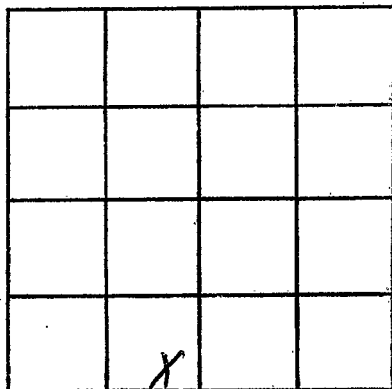

SECTION 27

Please indicate well location X.

ADDITIONAL INFORMATION

If more than one screen,
show locations of each on sketch.