

MISSISSIPPI DEPARTMENT OF NATURAL RESOURCES

Bureau of Land and Water Resources

Southport Mall

P.O. Box 10631

Jackson, Mississippi 39209

WATER WELL DRILLERS LOG

NEBRASKA
B 2007

1-30 1989 Smith's well Drilling Nebraska
date well completed firm name county well located

LANDOWNER: LEE STONE

(mailing address)

description of formations encountered	from	to
<u>red clay</u>	<u>7</u>	<u>12</u>
<u>sand & brick</u>	<u>7</u>	<u>502</u>
<u>brick</u>	<u>40</u>	<u>130</u>
<u>sand</u>	<u>110</u>	<u>155</u>

WELL LOCATION:
sec. 5 T. 12 N. R. 11 E.
S. W.
miles 0 of Willa
(distance) (direction) (nearest town)

WELL PURPOSE: FARM
(home, irrigation, municipal, industrial)

- WELL COMPLETION DATA:
- (1) diameter (inches) 4"
 - (2) total depth (feet) 155 ft
 - (3) static water level (feet) 22 ^(below) _(above) top of ground.
 - (4) casing 3/4" 145 ft
(material) (depth)
if telescope see back.
(size)
 - (5) screen 1 1/2" 1 1/2"
(length) (depth to top)
(size) (material)
 - (6) pump 1 2
(HP) (yield gpm)
(type power)
 - (7) electric log (yes or no)
(organization running log)
 - (8) how well bottom plugged _____

RECEIVED


NOV 26 1990

Department of Natural Resources
Bureau of Land & Water Resources

DRILLERS REMARKS:

If well telescopes please sketch and show depths.

GROUND LEVEL

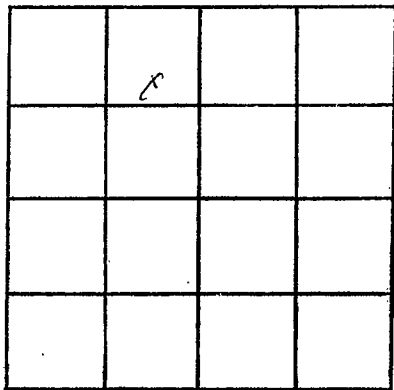

SECTION _____

Please indicate well location X.

ADDITIONAL INFORMATION

If more than one screen, show locations of each on sketch.