

6 13T

H C 2

WATER WELL DRILLERS LOG

6-1-63 CODED

Date: 6-1-1963 Driller: W J Ray County: Neshoba

(Name)

(1) Owner of Land:	Description & Color of Materials Sand, Clay, Red Clay, Shell, etc.	Thick- ness Feet	Depth Feet
(Name) <u>Hays Kelpstra</u> (Address) <u>Phila Rth 2</u>	<del>_____</del> <u>Sand to 20ft yellow</u>		
(2) Location: <u>1/4</u> , <u>1/4</u> , Sec <u>35 12 12</u> T <u>R</u> <u>1/8</u> miles <u>East</u> of <u>Phila</u> (distance) (direction) (Nearest Town)	<u>Blue Clay to 8ft</u>		
(3) Topography: <input checked="" type="checkbox"/> (Hilly) <input type="checkbox"/> (Flat) <input type="checkbox"/> (Level)	<u>Blue sand 85-</u>		
(4) Purpose of Well: <u>Domestic</u> (Domestic Irrigation Municipal, Industrial, Other)	<u>100 ft</u>		

Information upon completion of well:


- (1) Diameter 2 inches.
- (2) Total Depth 100 feet.
- (3) Water Level 40 feet below top of ground.
- (4) Cased to 78, Size 2 in
- (5) Screen: Size none Length \_\_\_\_\_
- (6) Were any formations sealed against pollution?  
 yes,  no.

If YES depth of formation \_\_\_\_\_

Why \_\_\_\_\_

Drillers Remarks: \_\_\_\_\_

CODED

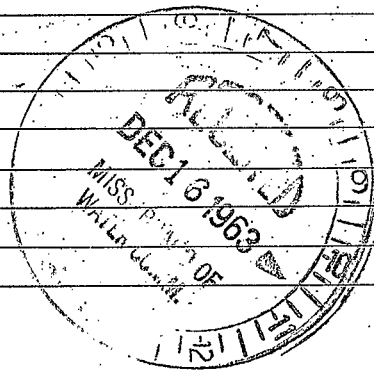

(Use Back Side)

Well No.

