

Neshoba

C4

4-2-73

MISSISSIPPI BOARD OF WATER COMMISSIONERS 416 North State Street Jackson, Mississippi 39201

CODED

WATER WELL DRILLERS LOG

16-2 1973 Hestogletre neshoba date well completed firm name county well located

LANDOWNER: Charles R. ...

description of formations encountered

from to

RT #

neshoba miss. (mailing address)

WELL LOCATION:

sec 3 T 14 N R 12 E S W

16 miles NORTH of Shila (distance) (direction) (nearest town)

WELL PURPOSE:

(home, irrigation, municipal, industrial)

WELL COMPLETION DATA:

- (1) diameter (inches) 2
(2) total depth (feet) 495
(3) static water level (feet) 45 below top of ground.

(4) casing 2 1/2" (material) 485 (depth)

3" (size) if telescope see back.

(5) screen 10 (length) 495 (depth to top)

1/2" (size) (material)

(6) pump 1/2 (HP) 8 (yield gpm)

PER (type power)

(7) electric log (yes or no)

(organization running log)


(8) how well bottom plugged

DRILLERS REMARKS:

CODED

If well telescopes please sketch and show depths.

GROUND LEVEL

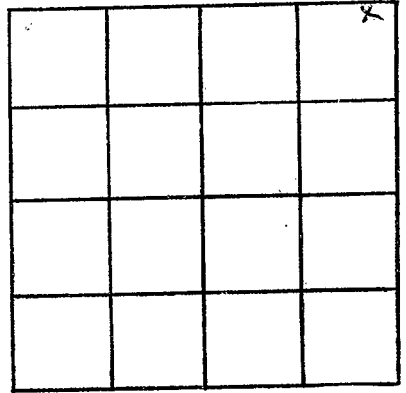

SECTION _____

Please indicate well location X.

ADDITIONAL INFORMATION

If more than one screen, show locations of each on sketch.