

NESHOPA

MISSISSIPPI BOARD OF WATER COMMISSIONERS

6 13T

Bore?

WATER WELL DRILLERS LOG

C 5 CODED

8-16-61

Date: 8/16, 1961, Driller: Hester Dyer, Hester County, Neshoba

(Name)

(1) Owner of Land:	Description & Color of Materials Sand, Clay, Red Clay, Shell, etc.	Thick- ness Feet	Depth Feet
Mrs. Gladys ⁰⁰ Mundy (Name) Route 6 Phila, Miss. (Address)	20ft. clay & sand 100ft. blue dirt 30ft. water sand		
(2) Location: 1/4, 1/4, Sec. T. R.			
11 miles north, of Phila (distance) (direction) (Nearest Town)			
(3) Topography: hilly			
(4) Purpose of Well: home use			

Information upon completion of well:


- (1) Diameter 4 inches.
- (2) Total Depth 150 feet.
- (3) Water Level 70 feet below top of ground.
- (4) Cased to 84, Size 2 in.
- (5) Screen: Size _____, Length _____.
- (6) Were any formations sealed against pollution?
 yes, no.

If YES depth of formation _____

Why _____

Drillers Remarks: _____

CODED

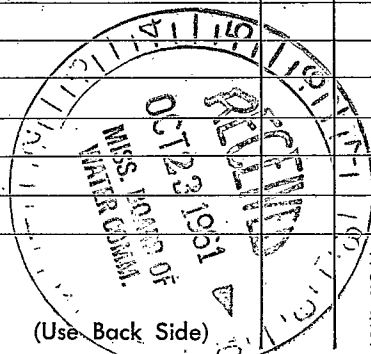

(Use Back Side)

Well No.

