

CL
10-66

5 135

WATER WELL DRILLERS LOG

CODED

Date: Oct 21, 1966, Driller: McKay County Philadelphia

(1) Owner of Land: Miss Beulah
553 1/2 N. (Near) Dale St
Jackson Miss
(Address)
Lot 3
(2) Location: 1/4, 1/4, Sec. 36 T12R12
6 miles NE of Philadelphia
(distance) (direction) (Nearest Town)
(3) Topography: (Hilly) (Flat) (Level)
(4) Purpose of Well: Home
(Domestic Irrigation
Municipal, Industrial, Other)

Description & Color of Materials Sand, Clay, Red Clay, Shell, etc.	Thick- ness Feet	Depth Feet
<u>Red Clay</u>	<u>20</u>	<u>20</u>
<u>Blue Clay</u>	<u>60</u>	<u>80</u>
<u>Fine Sand</u>	<u>40</u>	<u>120</u>
<u>Sandy Shale</u>	<u>20</u>	<u>140</u>
<u>Hard Shale</u>	<u>60</u>	<u>200</u>
<u>Fine Sand</u>	<u>20</u>	<u>220</u>
<u>Med Sand</u>	<u>20</u>	<u>240</u>

Philadelphia


Information upon completion of well:

(1) Diameter 4x2 inches.
(2) Total Depth 240 feet.
(3) Water Level 77 feet below top of ground.
(4) Cased to 120, Size 4"
(5) Screen: Size 007, Length 20
(6) Were any formations sealed against pollution?
no

2 Pye Jet Pump

CODED

If YES depth of formation _____
Why _____
Drillers Remarks: _____

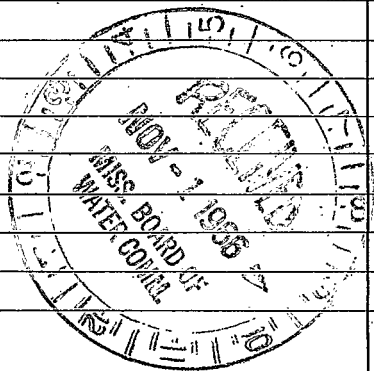

(Use Back Side)

Well No.

