

613T

8

H C 7

12-63

CODED

WATER WELL DRILLERS LOG

Date: 12 / 1, 1963, Driller: M J Ray

County: Neshoba

(Name)

(1) Owner of Land: J. J. J. J. J.  
 (Name)  
White miss R #2  
 (Address)

(2) Location: 3 5 12 12  
 1/4, 1/4, Sec. T R  
1 1/2 miles East, of White  
 (distance) (direction) (Nearest Town)

(3) Topography: V  
 (Hilly) (Flat) (Level)

(4) Purpose of Well: Domestic  
 (Domestic Irrigation, Municipal, Industrial, Other)

Description & Color of Materials Sand, Clay, Red Clay, Shell, etc.	Thick- ness Feet	Dept Fee
<u>Blue dirt &amp; yellow sand mixed to</u>	<u>30 ft</u>	
<u>Blue dirt to</u>	<u>40 ft</u>	
<u>Gray sand &amp; s</u>	<u>100 - ft</u>	

Information upon completion of well:

(1) Diameter 2 inches.

(2) Total Depth 100 feet.

(3) Water Level 40 feet below top of ground.

(4) Cased to 6 3/4 Size

(5) Screen: Size none Length \_\_\_\_\_

(6) Were any formations sealed against pollution?  
 \_\_\_\_\_ yes, V no.


If YES depth of formation \_\_\_\_\_

Why \_\_\_\_\_

Drillers Remarks: \_\_\_\_\_

\_\_\_\_\_

\_\_\_\_\_

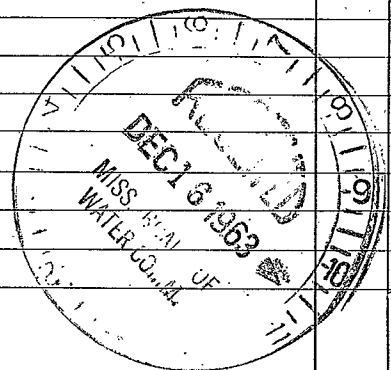

(Use Back Side)

Well No. \_\_\_\_\_

