

Neshoba

CODED 3 131

C 8

4-67

MISSISSIPPI BOARD OF WATER COMMISSIONERS
416 North State Street
Jackson, Mississippi 39201

WATER WELL DRILLERS LOG

APRIL 18
date well completed

1967 OGLETHORPE DRILLING
firm name

NESHOPA CO.
county well located

LANDOWNER: JOHNNIE LITTLE

description of formations encountered

from

to

RT. 6 PHILA., MISS.

RED CLAY AND SAND

0 30

BLUE CHALK

30 95

(mailing address)

GRAY SAND

95 100

WELL LOCATION:

sec. 30 T 12 N R 12 E
S W
6 miles NORTH PHILA.
(distance) (direction) (nearest town)

WELL PURPOSE: HOME USE
(home, irrigation, municipal, industrial)

WELL COMPLETION DATA:


- (1) diameter (inches) 2"
- (2) total depth (feet) 110
- (3) static water level (feet) 18 below above
top of ground.
- (4) casing GAV. 105
(material) (depth)

____ if telescope see back.
(size)
- (5) screen 5FT. 110-105
(length) (depth to top)
1 1/2 STAINLESS STEEL
(size) (material)
- (6) pump 3/4 7
(HP) (yield gpm)

REA
(type power)
- (7) electric log NO
(yes or no)

(organization running log)
- (8) how well bottom plugged POINT

CODED

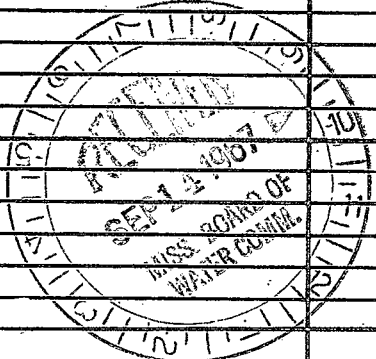

DRILLERS REMARKS:

If well telescopes please sketch and show depths.

GROUND LEVEL

			X

SECTION 30

Please indicate well location X.

ADDITIONAL INFORMATION

If more than one screen,
show locations of each on sketch.