

5 13T

325150 N 0890200

CODED

TETU

Neshoba
C9
10-30-68

MISSISSIPPI
BOARD OF WATER COMMISSIONERS
416 North State Street
Jackson, Mississippi 39201

WATER WELL DRILLERS LOG

10-30 1968 B B Nicholson Neshoba
date well completed firm name county well located


LANDOWNER: Larry Crawford
Shila
Miss - Rt 3
(mailing address)

description of formations encountered	from	to
Clay calc	0'	30'
Med Sand & Blue	30'	55'
Blue dirt	55'	150'
water sand	150'	177'

WELL LOCATION:
sec 26 T 12 N R 12 E
14 miles East of Shila
(distance) (direction) (nearest town)

WELL PURPOSE: Home
(home, irrigation, municipal, industrial)


- WELL COMPLETION DATA:
- (1) diameter (inches) 4 1/4"
 - (2) total depth (feet) 177'
 - (3) static water level (feet) 75' below top of ground.
 - (4) casing Lead Pipe 1 1/2" (material) (depth)
7" (size) If telescope see back.
 - (5) screen 5' 177' (length) (depth to top)
1 1/2" (size) Steel (material)
 - (6) pump 1 (HP) 8 (yield gpm)
Electric (type power)
 - (7) electric log NO (yes or no)
NO (organization running log)
 - (8) how well bottom plugged Screen

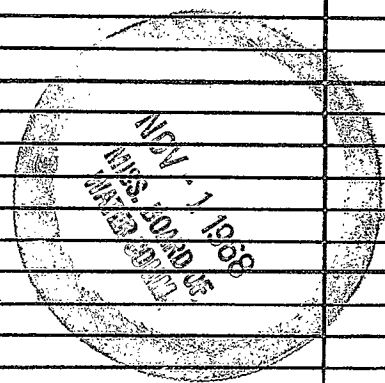

DRILLERS REMARKS:

If well telescopes please sketch and show depths.

GROUND LEVEL

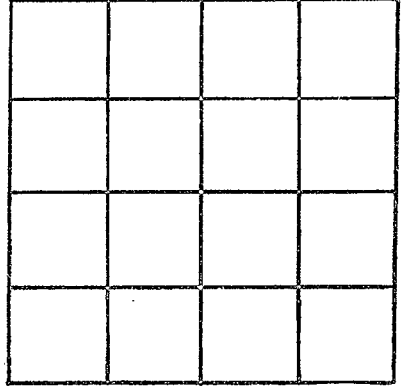

SECTION 26

Please indicate well location X.

ADDITIONAL INFORMATION

If more than one screen, show locations of each on sketch.