

C-10

10-2-61

WATER WELL DRILLERS LOG

CODED

Date: 10-2, 1961, Driller: M. S. King County: Washington


(Name)

(1) Owner of Land:	Description & Color of Materials Sand, Clay, Red Clay, Shell, etc.	Thick- ness Feet	Depth Feet
<u>Paul Brown</u> (Name)	<u>blue clay</u>		<u>50ft</u>
<u>Washington R# 1</u> (Address)	<u>blue clay</u>	<u>2</u>	<u>40</u>
(2) Location: <u>5</u> <u>1212</u> <u>15</u> miles <u>north</u> of <u>Rhike</u> (distance) (direction) (Nearest Town)	<u>11 sand</u>	<u>2</u>	<u>89</u>
(3) Topography: <u>level</u> (Hilly) (Flat) (Level)			
(4) Purpose of Well: <u>drinking</u> (Domestic Irrigation Municipal, Industrial, Other)			

Information upon completion of well:

- (1) Diameter 2 inches.
- (2) Total Depth 289 feet.
- (3) Water Level 71 feet below top of ground.
- (4) Cased to 105, Size 2 in
- (5) Screen: Size _____, Length _____
- (6) Were any formations sealed against pollution?
_____ yes, no.

If YES depth of formation _____
 Why _____
 Drillers Remarks: _____

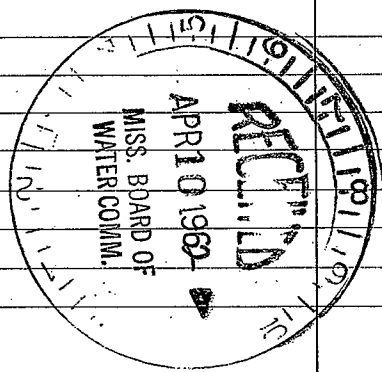

(Use Back Side)

Well No.

