

NESSHOBA

C12

2-2-74

MISSISSIPPI BOARD OF WATER COMMISSIONERS 416 North State Street Jackson, Mississippi 39201

CODED

WATER WELL DRILLERS LOG

Feb 2 1974 Beck Smith Neshoba date well completed firm name county well located

LANDOWNER: mike parker

phila. miss

(mailing address)

description of formations encountered

from to

red clay 0 35 blue chalk 35 195 gray sand 195 220

WELL LOCATION:

sec. 5 T. 12 N. R. 17 E. S. W. 3 miles east of Stalls (distance) (direction) (nearest town)

WELL PURPOSE: home (home, irrigation, municipal, industrial)

WELL COMPLETION DATA:

- (1) diameter (inches) 2" (2) total depth (feet) 230' (3) static water level (feet) 40 below above top of ground. (4) casing galv. 210' (material) (depth) 2" (size) if telescope see back. (5) screen 2-5' 210 (length) (depth to top) .008 stainless steel (size) (material) (6) pump 1 HP 6 (HP) (yield gpm) elec. (type power) (7) electric log (yes or no)

(organization running log)

(8) how well bottom plugged back wash valve


DRILLERS REMARKS:

CODED

MAR 18 1974

If well telescopes please sketch and show depths.

GROUND LEVEL

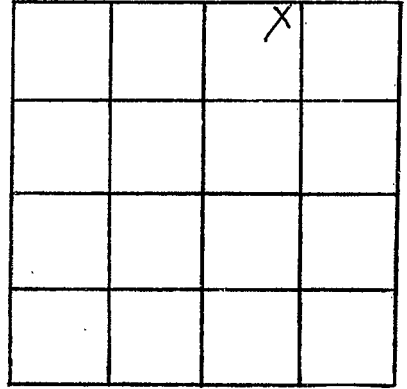

SECTION \_\_\_\_\_

Please indicate well location X.

ADDITIONAL INFORMATION

If more than one screen,  
show locations of each on sketch.