

Neshoba
~~548~~ Cbb
 9-1-71

MISSISSIPPI
 BOARD OF WATER COMMISSIONERS
 416 North State Street
 Jackson, Mississippi 39201

WATER WELL DRILLERS LOG

CODED

9-1-71 date well completed
 1971 firm name
 county well located

LANDOWNER: Burnside Park
 (mailing address)

| description of formations encountered | from | to |
|---------------------------------------|------------|------------|
| <u>1. sand</u> | <u>0</u> | <u>20</u> |
| <u>2. sand</u> | <u>20</u> | <u>50</u> |
| <u>3. sand clay</u> | <u>50</u> | <u>100</u> |
| <u>4. water table</u> | <u>100</u> | <u>516</u> |

WELL LOCATION: 12N
 sec 31 T 4S R 12W
4 miles (distance) N (direction) of Philo (nearest town)

WELL PURPOSE:
 (home, irrigation, municipal, industrial)

WELL COMPLETION DATA:

- (1) diameter (inches) 4
- (2) total depth (feet) 516
- (3) static water level (feet) 12 below above top of ground.
- (4) casing (material) 526 (depth)
 (size) if telescope see back.
- (5) screen (length) 20 (depth to top)
 (size) Johnson (material)
- (6) pump (HP) 20 (yield gpm)
 (type power)
- (7) electric log (yes or no)
 (organization running log)
- (8) how well bottom plugged

CODED

OCT 7 1971

MISS. BD. OF
 WATER COMM.

DRILLERS REMARKS:

If well telescopes please sketch and show depths.

flat


GROUND LEVEL

4"
103

2"

103

20
screen

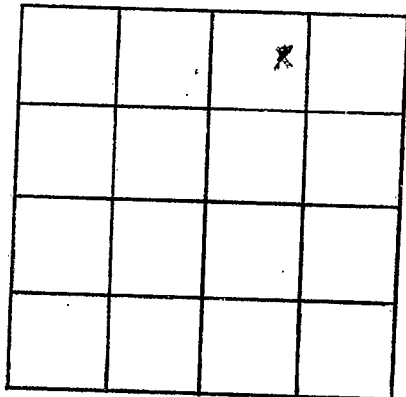

SECTION _____

Please indicate well location X.

ADDITIONAL INFORMATION

If more than one screen, show locations of each on sketch.