

Neshoba
 C 2000
 10-6-75

MISSISSIPPI
 BOARD OF WATER COMMISSIONERS
 416 North State Street
 Jackson, Mississippi 39201

WATER WELL DRILLERS LOG

10.6.75 date well completed 19 McDONALD + HILL firm name NESHObA county well located

| LANDOWNER: | description of formations encountered | from | to |
|--|---------------------------------------|------|-----|
| Chutkan W. H. Co. Commis. Philadelph. Mass (mailing address) | clay | 0 | 16 |
| | sand | 16 | 30 |
| | BLUE CLAY | 30 | 95 |
| | sand | 95 | 100 |
| | 19 hrs NORTH Rock | 100 | 102 |
| | shale | 102 | 148 |
| | fine sand | 148 | 195 |
| | course sand | 195 | 210 |

LANDOWNER:

description of formations encountered

from to

Chutkan W. H. Co. Commis. Philadelph. Mass (mailing address)

WELL LOCATION:

NO MAP OF MISSISSIPPI 13T
 sec. T N R E
 33 12S 7E
 10 miles North Philadelphia (distance) (direction) (nearest town)

WELL PURPOSE: HOME (home, irrigation, municipal, industrial)

WELL COMPLETION DATA:


- (1) diameter (inches) 4 1/2
- (2) total depth (feet) 210'
- (3) static water level (feet) 75' below top of ground.
- (4) casing PVC 200' (material) (depth)
 4 1/2" (size) If telescope see back.
- (5) screen 10' 200' (length) (depth to top)
 2" (size) PVC (material)
- (6) pump 3/4 Sub 10 (HP) (yield gpm)
 E (type power)
- (7) electric log (yes or no)
- (organization running log)
- (8) how well bottom plugged VALVE

DRILLERS REMARKS:

OCT 24 1975
 MISSISSIPPI BOARD OF WATER COMMISSIONERS

If well telescopes please sketch and show depths.

GROUND LEVEL

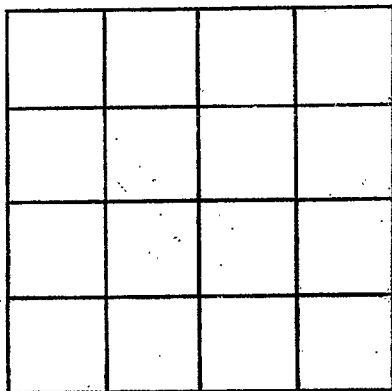

SECTION _____

Please indicate well location X.

ADDITIONAL INFORMATION

If more than one screen, show locations of each on sketch.