

D 2

5 131

(7)

WATER WELL DRILLERS LOG

3-19-62 CODED

Date: 3-19, 1962, Driller: Marshall Reynolds County Marshall

(Name)

(1) Owner of Land: John McKey
 (Name)
2 1/3 Miles East Bond
58 North
 (Address)

(2) Location: 1/4, 1/4, Sec. 26 T12R13
12 miles North E, of Philadelphia
 (distance) (direction) (Nearest Town)

(3) Topography: X
 (Hilly) (Flat) (Level)

(4) Purpose of Well: Domestic
 (Domestic Irrigation
 Municipal, Industrial, Other)

Description & Color of Materials Sand, Clay, Red Clay, Shell, etc.	Thick- ness Feet	Depth Feet
0-20 Heavy Clay		
20-100 Very fine		
100-100-100		
Hard Shell with thin		
layers of very brittle		
hard shell		
160 to 223- Hard green		
223-228 1/2 Sandstone		
Red rock well		
228 1/2 to 260- Very brittle		
Sand with shells		
260-265 Pumping water		
From 265		

Information upon completion of well:

(1) Diameter 2 inches.

(2) Total Depth 260 feet.

(3) Water Level 50 feet below top of ground.

(4) Cased to 160, Size 2

(5) Screen: Size _____, Length _____

(6) Were any formations sealed against pollution?
 _____ yes, _____ no.


Flow 3 @ 100 P.M.
 7.4
 119 P.M.
 Draw down 150 Feet
 A 2000 G.P.M.

CODED

If YES depth of formation _____

Why _____

Drillers Remarks: well was
abandoned after

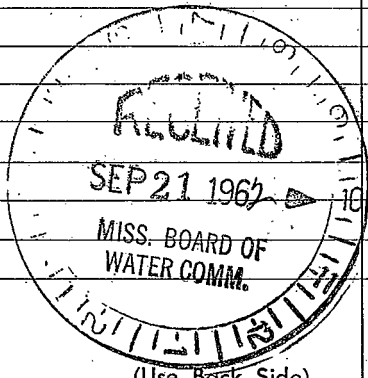

(Use Back Side)

Well No.

