

D3  
4-17-61

WATER WELL DRILLERS LOG

**CODED**

Date: 4-17, 1961, Driller: R R Nesheba, County Neshoba  
BC-10 Eastern Gravier (Name)

(1) Owner of Land: W. S. Scott  
(Name)  
Phila. Miss  
(Address)  
35 12 13

(2) Location: 15 miles East of Phila.  
(distance) (direction) (Nearest Town)

(3) Topography: Hilly  
(Hilly) (Flat) (Level)

(4) Purpose of Well: Domestic  
(Domestic Irrigation  
Municipal, Industrial, Other)

Description & Color of Materials Sand, Clay, Red Clay, Shell, etc.	Thick- ness Feet	Depth Feet
<u>Clay &amp; sand</u>	<u>1 to</u>	<u>23</u>
<u>Red dirt</u>	<u>23</u>	<u>100</u>
<u>fine sand &amp; blue dirt</u>	<u>100</u>	<u>115</u>
<u>Water sand</u>	<u>115</u>	<u>126</u>

Information upon completion of well:

**CODED**

(1) Diameter 3 7/8 inches.

(2) Total Depth 126 feet.

(3) Water Level 75 feet below top of ground.

(4) Cased to bottom, Size 2


(5) Screen: Size 1/4, Length 10 ft

(6) Were any formations sealed against pollution?  
X yes, no.

If YES depth of formation 25 ft 4" pipe

Why Sanitary Purpose

Drillers Remarks: water sand  
is very fine  
94 ft to cylinder

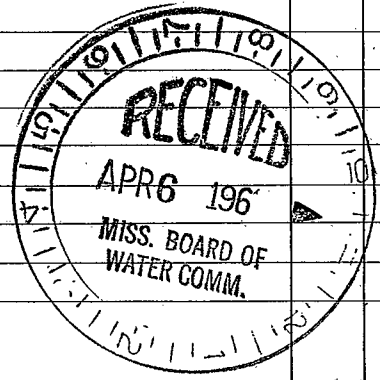

(Use Back Side)

Handwritten notes at the top of the page, including the word "Lecture" and some illegible scribbles.

Main body of handwritten notes, appearing as a series of lines of text, mostly illegible due to fading and bleed-through.

Handwritten notes at the bottom of the page, including the word "Lecture" and some illegible scribbles.