

513T

Neshoba
CODED
3-67

MISSISSIPPI
BOARD OF WATER COMMISSIONERS
416 North State Street
Jackson, Mississippi 39201
WATER WELL DRILLERS LOG

March 28 19 67 Ogletree Drilling Neshoba
date well completed firm name county well located

LANDOWNER: Tommy Stewart

description of formations encountered from to

Rt. 3

Philadelphian Miss.
(mailing address)

Red Sand and Clay 0 35
Blue Chalk 35 130
White and Gray Sand 130 147

WELL LOCATION:

sec. 30 T. 12 N. R. 13 E.
S W
8 miles N.E. of Phila.
(distance) (direction) (nearest town)


WELL PURPOSE: Home use
(home, irrigation, municipal, industrial)

WELL COMPLETION DATA:

- (1) diameter (inches) 2"
- (2) total depth (feet) 147
- (3) static water level (feet) 45 ^{below} _{above} top of ground.
- (4) casing Gav. 105
(material) (depth)
2" (size) if telescope see back.
- (5) screen None
(length) (depth to top)
None (size) (material)
- (6) pump 1 5 1/2
(HP) (yield gpm)
Elec (type power)
- (7) electric log No
(yes or no)
~~Ogletree Drilling~~
(organization running log)
- (8) how well bottom plugged Open


CODED

DRILLERS REMARKS:

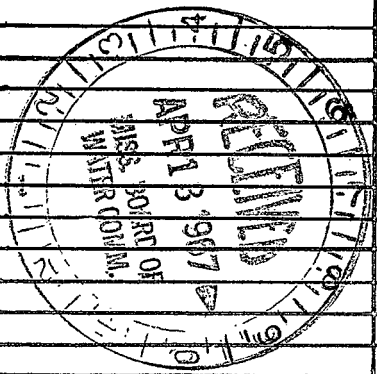

If well telescopes please sketch and show depths.

GROUND LEVEL

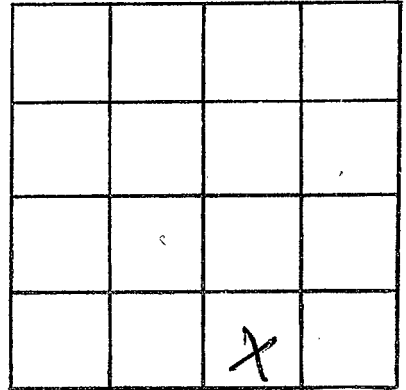

SECTION 30

Please indicate well location X.

ADDITIONAL INFORMATION

If more than one screen, show locations of each on sketch.