

*Neshoba*  
 D ~~POINTED~~  
 5-68

MISSISSIPPI  
 BOARD OF WATER COMMISSIONERS  
 416 North State Street  
 Jackson, Mississippi 39201

WATER WELL DRILLERS LOG

5-29 1968 OGLETREE DRILLING NESHOPA  
 date well completed firm name county well located

LANDOWNER: BOBBIE LOFTEN

PHILADELPHIA

(mailing address)

WELL LOCATION:

sec. 29 T 12 N R 13 E  
 S W  
 6 1/2 miles NORTH of PHILA.  
 (distance) (direction) (nearest town)

WELL PURPOSE: HOME USE  
 (home, irrigation, municipal, industrial)

WELL COMPLETION DATA:

- (1) diameter (inches) 2"
- (2) total depth (feet) 118
- (3) static water level (feet) 47 below top of ground.
- (4) casing GAV. 113  
 (material) (depth)  
 (size) if telescope see back.
- (5) screen 5' 118-113  
 (length) (depth to top)  
 1 1/4 STAINLESS STEEL  
 (size) (material)
- (6) pump 3/4 6  
 (HP) (yield gpm)  
 ELEC  
 (type power)
- (7) electric log \_\_\_\_\_  
 (yes or no)

(organization running log)

(8) how well bottom plugged POINTED

DRILLERS REMARKS:

description of formations encountered

from to

RED CLAY	0	20
BLUE CHALK	20	100
WHITE SAND	100	118


COBED

AUG 13 1968

MISS. BD. OF  
 WATER COMM.

If well telescopes please sketch and show depths.

GROUND LEVEL

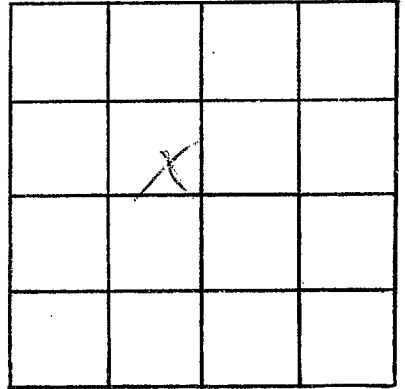

SECTION \_\_\_\_\_

Please indicate well location X.

ADDITIONAL INFORMATION

If more than one screen,  
show locations of each on sketch.