

TETU

MISSISSIPPI BOARD OF WATER COMMISSIONERS
416 North State Street
Jackson, Mississippi 39201

WATER WELL DRILLERS LOG

3
NESHOSA

D 10

9-2-68

Sept 2 1968 Beck Smith Neshoba
date well completed firm name county well located

LANDOWNER: Wendell Cotton

Phila, Rt 3

Miss.

(mailing address)

description of formations encountered

from to

red dirt

0 60

blue chalk

60 105

gray sand

105 120

WELL LOCATION:

sec. 2 T. 12 N. R. 13 E
6 miles NE of PHILA
(distance) (direction) (nearest town)

WELL PURPOSE: home
(home, irrigation, municipal, industrial)

WELL COMPLETION DATA:

(1) diameter (inches) 2"
(2) total depth (feet) 120
(3) static water level (feet) _____ below
top of ground. above

(4) casing galv, 115',
(material) (depth)
2"
(size) if telescope see back.


(5) screen 5', 115'
(length) (depth to top)
8, stainless steel
(size) (material)

(6) pump 1 HP
(HP) (yield gpm)
Elco
(type power)

(7) electric log NO
(yes or no)
-
(organization running log)


(8) how well bottom plugged lock
wash valve

DRILLERS REMARKS:

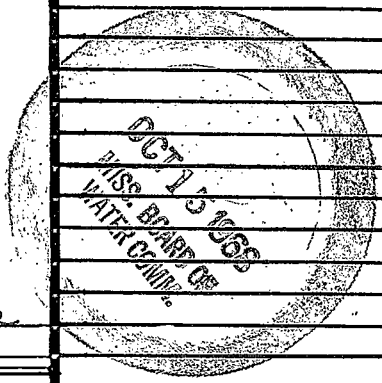

If well telescopes please sketch and show depths.

GROUND LEVEL

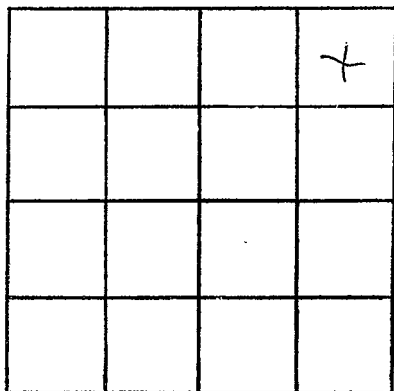

SECTION 2

Please indicate well location X.

ADDITIONAL INFORMATION

If more than one screen, show locations of each on sketch.