

WESHORA
D13
5-15-61

WATER WELL DRILLERS LOG

CODED

Date: 5-15, 1961, Driller: P.B. Nichols County Neshoba
BC-17 (Name) Jackson

(1) Owner of Land: V.S. Goult
(Name)
Shila, Miss.
(Address)
(2) Location: 351213 1/4, 1/4, Sec. T, R R
15 miles east of Shila
(distance) (direction) (Nearest Town)
(3) Topography: Hilly
(Hilly) (Flat) (Level)
(4) Purpose of Well: Domestic
(Domestic Irrigation
Municipal, Industrial, Other)


Description & Color of Materials Sand, Clay, Red Clay, Shell, etc.	Thick- ness Feet	Depth Feet
<u>Chalk & Gravel</u>	<u>1</u>	<u>25</u>
<u>black dirt</u>	<u>25</u>	<u>40</u>
<u>blue dirt</u>	<u>40</u>	<u>58</u>
<u>water sand</u>	<u>68</u>	<u>84</u>

Information upon completion of well:

(1) Diameter 3 7/8 inches.
(2) Total Depth 84' feet.
(3) Water Level 55 feet below top of ground.
(4) Cased to bottom, Size 2"
(5) Screen: Size 1 1/4, Length 10'
(6) Were any formations sealed against pollution?
✓ yes, no.

CODED

If YES depth of formation 26' of 4" pipe
Why sanitary purpose
Drillers Remarks: fine sand
6 3/4 ft. to cylinder

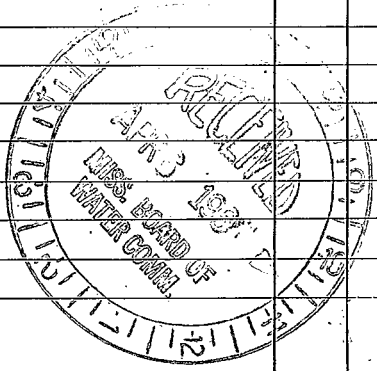

(Use Back Side)

Well No.

Handwritten notes at the top of the page, including a large heading that appears to be "The History of the..." and several lines of text below it.

Handwritten notes in the middle section, possibly a list or a set of instructions.

Vertical handwritten notes on the right side of the page.

Handwritten notes at the bottom of the page, including a large heading and several lines of text.