

NESTHOBA

D14

WATER WELL DRILLERS LOG

CODED

5-15-61

Date: 5-15, 1961, Driller: B.R. Nicholas, County: Neshoba

BC-16, Water Well Driller (Name)

(1) Owner of Land: U.B. Hunt, Phila. Miss. (Name, Address)

(2) Location: 1/4, 35 12 13, 15 miles east of Phila. (distance, direction, Nearest Town)

(3) Topography: Hilly (Hilly, Flat, Level)

(4) Purpose of Well: Domestic (Domestic Irrigation, Municipal, Industrial, Other)

Table with 3 columns: Description & Color of Materials, Thickness Feet, Depth Feet. Rows include: Wash & Sand (1' 22'), Yellow dirt (22' 40'), Blue dirt (40' 75'), Water sand (71' 94')

Information upon completion of well:

(1) Diameter 3 7/8 inches.

(2) Total Depth 94' feet.

(3) Water Level 50 feet below top of ground.

(4) Cased to bottom, Size 2"

(5) Screen: Size 1 1/4", Length 10'


(6) Were any formations sealed against pollution? yes, no.

If YES depth of formation 23' to 4" depth

Why Sanitary Purpose

Drillers Remarks: Fine sand

CODED

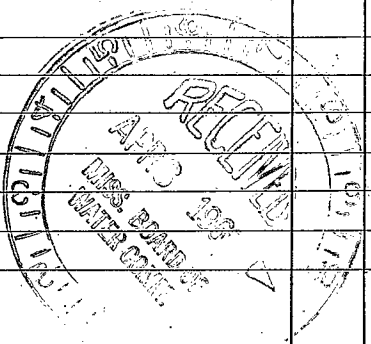

Well No.

(Use Back Side)

Handwritten notes at the top of the page, including the number '10' and some illegible scribbles.

Second section of handwritten notes, appearing as a list or series of short phrases.

Third section of handwritten notes, possibly containing a small diagram or a specific calculation.

Vertical handwritten notes on the right side of the page, possibly serving as a sidebar or index.

Bottom section of handwritten notes, which appears to be a summary or a final set of observations.