

D15

WATER WELL DRILLERS LOG

CODED

5-11-61

Date: 5-11, 1961, Driller: R.B. Nicholson County: Neshoba

BC-14 Bela Bell (Name)

(1) Owner of Land: V.B. Kent

Shila. V. Viss (Name)  
36 12 13 (Address)

(2) Location: 1/4, 1/4, Sec. T R  
15 miles east of Shila (distance) (direction) (Nearest Town)

(3) Topography: Hilly (Hilly) (Flat) (Level)

(4) Purpose of Well: Domestic (Domestic Irrigation Municipal, Industrial, Other)

Description & Color of Materials Sand, Clay, Red Clay, Shell, etc.	Thick- ness Feet	Depth Feet
Sand & Chalk	1'	20'
black dirt	20'	35'
blue dirt	35'	85'
water sand	85'	102'

Information upon completion of well:

(1) Diameter 3 7/8 inches.

(2) Total Depth 102 feet.

(3) Water Level 82 feet below top of ground.

(4) Cased to Bottom, Size 2"

(5) Screen: Size 1 1/4, Length 10 ft.


(6) Were any formations sealed against pollution?  
yes, no.

If YES depth of formation 21 ft 4' pipe

Why Sanitary Purpose

Drillers Remarks: fine sand  
cylinder 75 ft

CODED

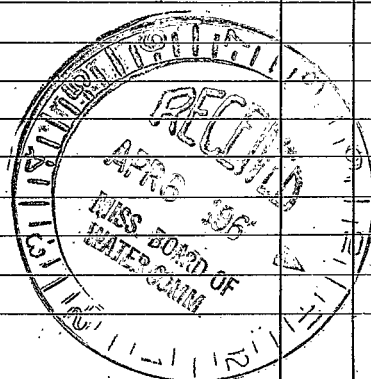

(Use Back Side)

Well No.

Handwritten notes at the top of the page, including the word "Lecture" and some illegible scribbles.

Handwritten notes in the upper middle section, possibly starting with "The..." and "is...".

Handwritten notes in the middle right section, including the word "and" and "the...".

Handwritten notes in the lower middle section, including the word "the..." and "is...".

Handwritten notes at the bottom of the page, including the word "the..." and "is...".