

D16

WATER WELL DRILLERS LOG

CODED

5-12-61

Date: 5-12-1966 Driller: R.B. Michelson County: Neshoba  
BC-15 Unit Franier

(1) Owner of Land: V.S. Kent  
(Name)  
Phila. Miss.  
(Address)

(2) Location: 157th East of Phila.  
(distance) (direction) (Nearest Town)

(3) Topography: Hilly  
(Hilly) (Flat) (Level)

(4) Purpose of Well: Domestic  
(Domestic Irrigation  
Municipal, Industrial, Other)

Description & Color of Materials Sandy Clay, Red Clay, Shell, etc.	Thick- ness Feet	Depth Feet
<u>Chalky Clay</u>	<u>1'</u>	<u>18'</u>
<u>Black dirt</u>	<u>18'</u>	<u>35'</u>
<u>Blue dirt</u>	<u>35'</u>	<u>85'</u>
<u>white sand</u>	<u>85'</u>	<u>100'</u>

Information upon completion of well:

(1) Diameter 3 7/8 inches.

(2) Total Depth 100' feet.

(3) Water Level 60 feet below top of ground.

(4) Cased to bottom Size 2"

(5) Screen: Size 1 1/4, Length 10'


(6) Were any formations sealed against pollution?  
 yes,  no.

CODED

If YES depth of formation 21' of 4" pipe

Why Sanitary Purposes

Drillers Remarks: fine sand  
it has 4" pump  
rod units

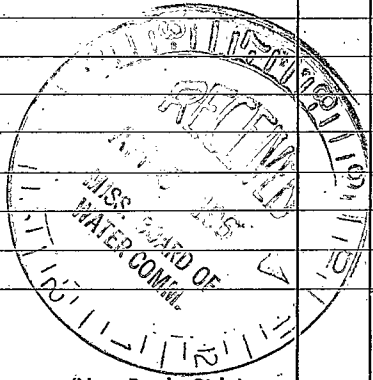

(Use Back Side)

Well No.

Handwritten notes at the top of the page, including the word "Singer" and other illegible scribbles.

Handwritten notes in the upper middle section, appearing as a list or series of entries.

Handwritten notes in the middle section, including the word "Singer" and other illegible scribbles.

Small handwritten notes or numbers on the right side of the page.

Small handwritten notes or numbers on the right side of the page.

Handwritten notes at the bottom of the page, including the word "Singer" and other illegible scribbles.