

MISSISSIPPI DEPARTMENT OF ENVIRONMENTAL QUALITY

Office of Land and Water Resources

P. O. Box 10631
Jackson, MS 39289-0631

WATER WELL DRILLERS LOG

COUNTY WELL LOCATED
Weshoba

WELL NUMBER D-17 CODED

DATE WELL COMPLETED
6-7-2003

PERMIT NUMBER
0-374

NAME OF DRILLING FIRM
Ms Water Well Drilling Co

NAME & MAILING ADDRESS OF LANDOWNER
Charles Bryan
Philadelphia Ms

Latitude:
Longitude:

WELL LOCATION: SEC 19 TOWNSHIP 12 RANGE N 13 E

DISTANCE 7 Miles DIRECTION N/W of NEAREST TOWN Philadelphia

OTHER LANDMARK

WELL PURPOSE: Home, Irrigation, Municipal, Industrial, Fish Pond, etc.

PUMP DATA

PUMP TYPE (Circle One):
 Submersible, Turbine, Jet, Flowing Well,
Other (Describe) 20 GPM

POWER TYPE (Circle One):
 Electric, Tractor, Diesel, Gasoline, Butane,
Other (Describe) L H/P

DESCRIPTION OF FORMATIONS ENCOUNTERED	FROM	TO
Top Soil & Clay	0	10
Sand	10	80
Lignite & Clay	80	110
Clay	110	180
Sand	180	200
Clay	200	380
Sand	380	430

WELL DATA

Well Depth 430 Casing Diameter (In.) 2 20' 4" Casing Length (Ft.) 400

Type of Casing PVC Hole Depth 430 Depth to Static Water Level 97'

TYPE OF COMPLETION: (Circle One or More):
Gravel Packed, Underreamed, Telescoped,
Natural Development, Open Hole, Other

WELL GROUTED TO A DEPTH OF 10 FEET
Type Grout (circle one): Cement, Bentonite, or Mix

SCREEN DATA

Diameter - Inches 2" Length - Feet 30' Slot Size - Inches #10

Screen Type PVC Depth to Bottom - Feet 430

RECEIVED

JUN 25 2003

BY: OLWR

Top of Lap Pipe or Reduction in Casing

FEET IF TELESCOPED OR MORE THAN ONE SCREEN: USE BACK PAGE


I certify that the well was drilled, constructed and completed in accordance with all applicable Requirements of the Mississippi Department of Environmental Quality and/or the Mississippi Department of Health regulations and state laws.

Nelson Cain
Signature of Licensed Driller and License No.

6/24/03
Date

Additional Information Required On Back

If well telescopes please sketch and show depths.

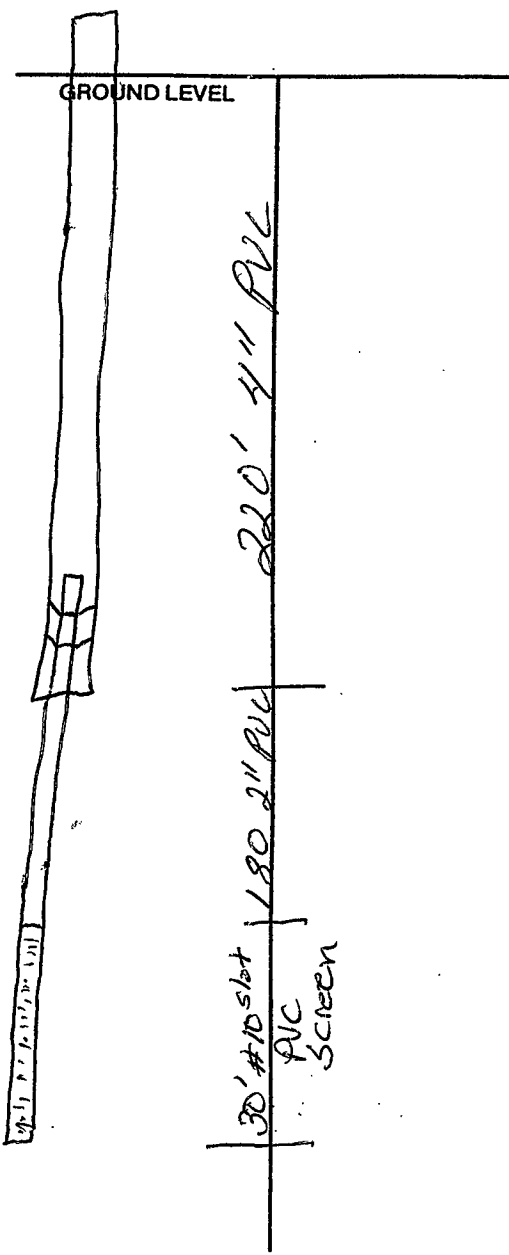

If more than one screen, show location of each on sketch.

SECTION _____

Please indicate well location X.

Pump Capacity (GPM)	No. of Stages	Setting Depth	FT.
---------------------	---------------	---------------	-----

PUMP TEST

Well yielded _____ GPM with a drawdown of _____ ft. after _____ hours of pumping

LOG DATA

TYPE OF LOG RUN (Circle One): No Log Run, Electric, Gamma Ray, Density, Sonic, Neutron, Other (Describe) _____

Name of Organization Running Log _____

GEOLOGIC DATA (Office Use Only)

Surface Elev.	Geologic Unit	Unit Thickness	Depth to Top
Subs. SWL	Date	Analysis	Aquifer Test

Driller's Remarks
