

Neshoba  
D 2000  
12-8-75


MISSISSIPPI  
 BOARD OF WATER COMMISSIONERS  
 416 North State Street  
 Jackson, Mississippi 39201

137

WATER WELL DRILLERS LOG

Dec 8 1975 Beck Smith Neshoba  
 date well completed firm name county well located


LANDOWNER:	description of formations encountered	from	to
<u>C. C. Free</u>			
<u>Phila, Miss -</u> (mailing address)	<u>blue Chalk</u>	<u>90</u>	<u>210</u>
	<u>gray sand</u>	<u>210</u>	<u>265</u>
<b>WELL LOCATION:</b>			
sec. <u>2</u> T <u>12</u> N R <u>13</u> E S W			
<u>11</u> miles <u>NE</u> of <u>Phila</u> (distance) (direction) (nearest town)			
<b>WELL PURPOSE:</b> <u>home</u> (home, irrigation, municipal, industrial)			
<b>WELL COMPLETION DATA:</b>			
(1) diameter (inches) <u>2"</u>			
(2) total depth (feet) <u>265</u>			
(3) static water level (feet) <u>120</u> <u>below</u> top of ground. above			
(4) casing <u>gal.</u> <u>255</u> (material) (depth)			
<u>2"</u> (size) if telescope see back.			
(5) screen <u>10'</u> <u>255</u> (length) (depth to top)			
<u>008</u> <u>Stainless Steel</u> (size) (material)			
(6) pump <u>1 1/2</u> <u>8</u> (HP) (yield gpm)			
<u>elec</u> (type power)			
(7) electric log (yes or no) _____			
(organization running log) _____			
(8) how well bottom plugged <u>back</u> <u>wash valve</u>			
<b>DRILLERS REMARKS:</b>			

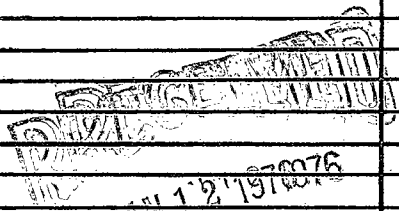

JAN 12 1976  
 MISS. BD. OF WATER COMMISSIONERS

If well telescopes please sketch and show depths.

GROUND LEVEL

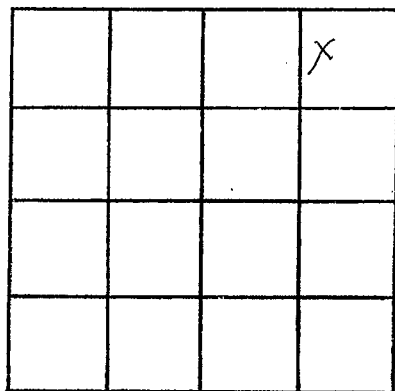

SECTION 2

Please indicate well location X.

ADDITIONAL INFORMATION

If more than one screen,  
show locations of each on sketch.