

Neshoba
D 2002
8/29/81

MISSISSIPPI
BOARD OF WATER COMMISSIONERS
416 North State Street
Jackson, Mississippi 39201

WATER WELL DRILLERS LOG

8/29 1981 Beck Smith Neshoba
date well completed firm name county well located

LANDOWNER: Petty
Phila, Miss.
(mailing address)

description of formations encountered	from	to
Top Soil	0	18
Red Sand	18	80
Blue Clay	80	275
Blue Sand	275	290

WELL LOCATION:
sec. 2 T 12 N R 13 E
S W
12 miles NE of Phila
(distance) (direction) (nearest town)

WELL PURPOSE: Home
(home, irrigation, municipal, industrial)

- WELL COMPLETION DATA:
- (1) diameter (inches) 2 1/2
 - (2) total depth (feet) 290 1/2
 - (3) static water level (feet) 85 ^{below} above top of ground.
 - (4) casing PVC 280 1/2
(material) (depth)
____ (size) if telescope see back.
 - (5) screen 10 1/2 280 1/2
(length) (depth to top)
0.010 PVC
(size) (material)
 - (6) pump 1/2 8
(HP) (yield gpm)
etc
(type power)
 - (7) electric log _____
(yes or no)

(organization running log)
 - (8) how well bottom plugged PVC PLUS

DEPT. OF NATURAL RESOURCES
BUREAU OF LAND & WATER RESOURCES


SEP - 8 1981

RECEIVED

DRILLERS REMARKS:

If well telescopes please sketch and show depths.

GROUND LEVEL

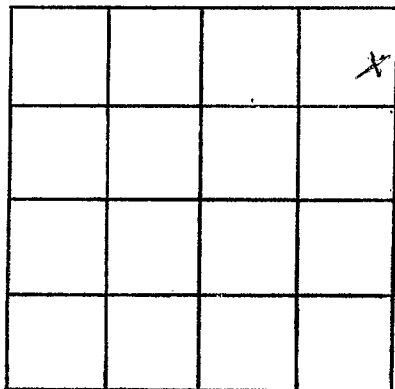

SECTION _____

Please indicate well location X.

ADDITIONAL INFORMATION

If more than one screen,
show locations of each on sketch.