

Neshoba 3 13T

E4

MISSISSIPPI BOARD OF WATER COMMISSIONERS

10-66 CODED


WATER WELL DRILLERS LOG

Date: 10-14, 1966, Driller: J. H. Walker, County Neshoba

1) Owner of Land: Curtis Rushing
Route 9, Phila Miss
2) Location: NW 1/4, SE 1/4, Sec. 20 T19R E
10 miles west of Phila
3) Topography: Hilly
4) Purpose of Well: Underhill Home

Table with 3 columns: Description & Color of Materials, Thickness Feet, Depth Feet. Contains handwritten entries for Red Clay and White Sand.

Information upon completion of well:
1) Diameter 2 inches
2) Total Depth 73 feet
3) Water Level 50 feet below top of ground
4) Cased to 68, Size 2
5) Screen: Size 1/4, Length 5 ft
6) Were any formations sealed against pollution?
YES depth of formation
Why
Drillers Remarks:
Yield in gpm: 7
Size pump: J.H.P.
Type power:

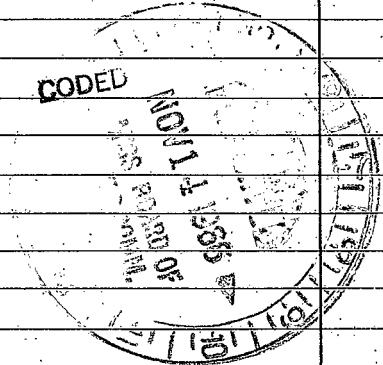

[The page contains extremely faint and illegible text, likely bleed-through from the reverse side of the document. The text is too light to transcribe accurately.]