

Neshoba
EQ
10-3-68

MISSISSIPPI
BOARD OF WATER COMMISSIONERS
416 North State Street
Jackson, Mississippi 39201

CODED

WATER WELL DRILLERS LOG

10-3 1968 Ogletree Drilling Co. Neshoba
date well completed firm name county well located

LANDOWNER:
August Hallman
Route 7 Phila. Miss.
(mailing address)

description of formations encountered	from	to
Red clay	0	20
Red + white sand	20	65
Rock + blue shell	65	100
White sand	100	138

WELL LOCATION:
sec. 32 T 11 N R 10 E
S W
10 miles West of Phila.
(distance) (direction) (nearest town)

WELL PURPOSE: Home & Farm
(home, irrigation, municipal, industrial)

WELL COMPLETION DATA:

(1) diameter (inches) 4"

(2) total depth (feet) 138

(3) static water level (feet) 90 below above top of ground.

(4) casing steel, 105, (material) (depth)

4x2 If telescope see back.
(size)

(5) screen 17' 138-121 (length) (depth to top)

2" Stokes steel (size) (material)

(6) pump 2 42 (HP) (yield gpm)

Reau (type power)

(7) electric log NO (yes or no)

(organization running log)

(8) how well bottom plugged Painted

DRILLERS REMARKS:

NOV 11 1968
MISS. Bd. of WATER COMMISSIONERS

If well telescopes please sketch and show depths.


GROUND LEVEL

4" - 105

3" Pipe 7 ft

17 ft Paints

7 ft 2" Pipe

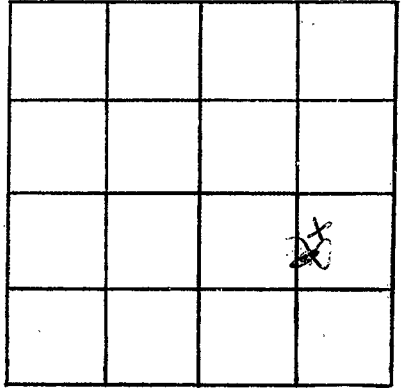

SECTION 32

Please indicate well location X.

ADDITIONAL INFORMATION

If more than one screen, show locations of each on sketch.