

NESHOBA
E 11
10-1-70

MISSISSIPPI
BOARD OF WATER COMMISSIONERS
416 North State Street
Jackson, Mississippi 39201

CODED

WATER WELL DRILLERS LOG

10-1-1970 19 *Neshoba Water Well Drilling Neshoba*
date well completed firm name county well located

LANDOWNER: *Clay Gibson*
Rt. 7 Phila. Miss.
(mailing address)

description of formations encountered	from	to
<i>long sand</i>		<i>4'</i>
<i>shale</i>		<i>1'</i>
<i>clay</i>		<i>3'</i>
<i>clay</i>	<i>1'</i>	<i>1'</i>
<i>clay</i>		<i>3'</i>

WELL LOCATION:
sec. *5* T. *11* N. R. *10* E.
108 miles of *10* miles (distance) (direction) (nearest town)

WELL PURPOSE: *domestic*
(home, irrigation, municipal, industrial)

- WELL COMPLETION DATA:
- (1) diameter (inches) *4*
 - (2) total depth (feet) *248*
 - (3) static water level (feet) *138* below above top of ground.
 - (4) casing *4" galv. steel* (material) *27* (depth)
if telescope see back. (size)
 - (5) screen *10* (length) *248* (depth to top)
4" galv. steel (size) (material)
 - (6) pump *1/2* (HP) *12* (yield gpm)
RF (type power)
 - (7) electric log (yes or no) _____
(organization running log) _____
 - (8) how well bottom plugged _____

CODED

NOV 3 1970


MISS. Bd. of Water Comm. MEMBER (signature)

DRILLERS REMARKS:

If well telescopes please sketch and show depths.

GROUND LEVEL

Well

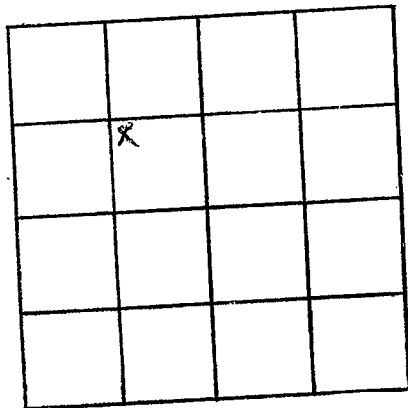

SECTION _____

Please indicate well location X.

ADDITIONAL INFORMATION

If more than one screen,
show locations of each on sketch.