

NESHOBA

E 12

10-16-70

MISSISSIPPI BOARD OF WATER COMMISSIONERS
416 North State Street
Jackson, Mississippi 39201

CODED

WATER WELL DRILLERS LOG

10-16

1970

date well completed

firm name

county well located

LANDOWNER: Herman Jim

description of formations encountered

from

to

(mailing address)

WELL LOCATION:

sec. 9 T. 11 N. R. 10 E. S. 1 W.

7 miles west of White
(distance) (direction) (nearest town)

WELL PURPOSE:
(home, irrigation, municipal, industrial)

WELL COMPLETION DATA:

- (1) diameter (inches) 14
- (2) total depth (feet) 120
- (3) static water level (feet) 19 below above top of ground.
- (4) casing 4 114
(material) (depth)
(size) if telescope see back.
- (5) screen 10 1-4
(length) (depth to top)
2" galvanized steel
(size) (material)
- (6) pump 1/2 20
(HP) (yield gpm)
P.A.A.
(type power)
- (7) electric log
(yes or no)

(organization running log)
- (8) how well bottom plugged

CODED


NOV 3 - 1970

MISS. BD. OF WATER COMM.

DRILLERS REMARKS:

If well telescopes please sketch and show depths.

Willy
GROUND LEVEL

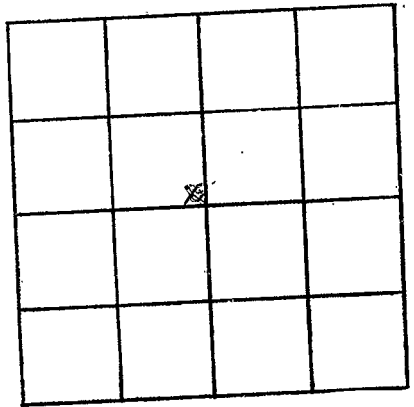

SECTION _____

Please indicate well location X.

ADDITIONAL INFORMATION

Lined area for additional information.

If more than one screen, show locations of each on sketch.