

NESHOPA
E 13
10-18-70

MISSISSIPPI
BOARD OF WATER COMMISSIONERS
 416 North State Street
 Jackson, Mississippi 39201
WATER WELL DRILLERS LOG

CODED

date well completed 10/18/70 firm name Forest Drilling county well located Neshoba Miss.

LANDOWNER: Choctaw Central High School - Philadelphia Miss. Project # LC-01-132
 (mailing address)

description of formations encountered	from	to
Clay	0	8
Sand	8	16
Black clay	16	30
Blue clay	30	40
Black clay	40	80
Blue clay	80	125
Fine to Med. Sand	125	149
Fine Sand & silt. shale	149	167
Blue shale	167	206
Silt & Clay	206	216
Shale	216	228

WELL LOCATION:
 sec 94 T 11 N R 10 E
6 miles W of Philadelphia
 (distance) (direction) (nearest town)

WELL PURPOSE: Treatment Plant
 (home, irrigation, municipal, industrial)

- WELL COMPLETION DATA:
- (1) diameter (inches) 4"
 - (2) total depth (feet) 149'
 - (3) static water level (feet) 44' below above top of ground.
 - (4) casing Steel, 132'
 (material) (depth)
4" If telescope see back.
 (size)
 - (5) screen 15', 134'
 (length) (depth to top)
3", Stainless Steel
 (size) (material)
 - (6) pump 3/4 900 RPM @ 40#
 (HP) (yield gpm)
220 V - 1 Ph. (4' drawdown)
 (type power)
 - (7) electric log -
 (yes or no)
- (organization running log)
- (8) how well bottom plugged 2"
Broken ash Ovals (Brass)

CODED

DEC 17 1970


MISSISSIPPI
 FOREST DRILLING SERVICE

DRILLERS REMARKS: Well Pumped at 29 RPM for 4 hrs. with 11 ft. drawdown. Instant recovery.

FOREST DRILLING SERVICE
 221 Highway 35 North
 FOREST, MISSISSIPPI

If well telescopes please sketch and show depths.

GROUND LEVEL

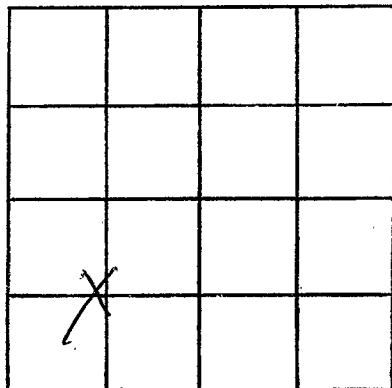

SECTION 24

Please indicate well location X.

ADDITIONAL INFORMATION

If more than one screen,
show locations of each on sketch.