

NESHOBA

E14

12-19-70

MISSISSIPPI BOARD OF WATER COMMISSIONERS 416 North State Street Jackson, Mississippi 39201

CODED

WATER WELL DRILLERS LOG

12-29-

1970 Wilburson Drilling Co.

Neshoba

date well completed

firm name

county well located

LANDOWNER: Thomas Alphonse Jr. Philadelphia, Miss. (mailing address)

Table with 3 columns: description of formations encountered, from, to. Rows include red clay, red sand, white sand, blue clay, rock & clay, sand, blue clay, pine grove sand.

WELL LOCATION: sec. 15 T. 11 N. R. 10 E. 9 miles west of Philadelphia (distance, direction, nearest town)

WELL PURPOSE: Home (home, irrigation, municipal, industrial)

- WELL COMPLETION DATA: (1) diameter (inches) 2 (2) total depth (feet) 380 (3) static water level (feet) 93 below top of ground. (4) casing galv. (material), 370 (depth) 2 (size) if telescope see back. (5) screen 10 (length), 370 (depth to top) 6 (size), stainless steel (material) (6) pump 1 (HP), 5 (yield gpm) Elect. (type power) (7) electric log no (yes or no) no (organization running log) (8) how well bottom plugged Cap

CODED


DEC 28 1970

DRILLERS REMARKS: no water in sand at 35 feet

MISS. BD. OF WATER COMM.

If well telescopes please sketch and show depths.

GROUND LEVEL

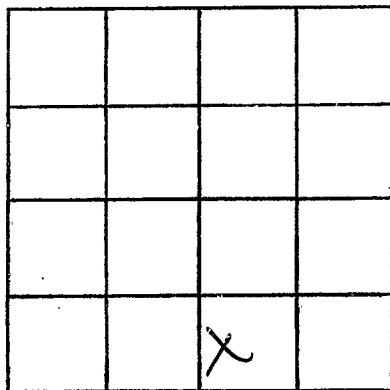

SECTION 15

Please indicate well location X.

ADDITIONAL INFORMATION

If more than one screen,  
show locations of each on sketch.