

NESHOBA

MISSISSIPPI BOARD OF WATER COMMISSIONERS

EIS

7-11-62

WATER WELL DRILLERS LOG

CODED

Date: 7-11, 1962, Driller: P.R. Nicholson, County: Neshoba

P.R. - 11 Frank Bell (Name)

(1) Owner of Land: U.S. Govt. (Name) Phila. Miss. (Address) 36 1170

(2) Location: 1/4, 1/4, Sec. T R, 7/4 miles West of Phila. (distance) (direction) (Nearest Town)

(3) Topography: Hilly (Hilly) (Flat) (Level)

(4) Purpose of Well: Domestic (Domestic Irrigation Municipal, Industrial, Other)

Description & Color of Materials Sand, Clay, Red Clay, Shell, etc.	Thick-ness Feet	Depth Feet
Clay & Chalk	1	10
rock	10	65
blue dirty shell	65	80
water sand	80	97

Information upon completion of well:

(1) Diameter 3 7/8 inches.

(2) Total Depth 97 feet.

(3) Water Level 65 feet below top of ground.

(4) Cased to Joint, Size 2"

(5) Screen: Size 2", Length 5'


(6) Were any formations sealed against pollution? yes, no.

If YES depth of formation 10' of 4" pipe

Why: Sanitary Purpose

Drillers Remarks: Cylinder set 84 ft

CODED

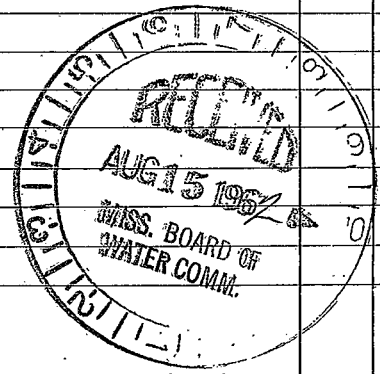

(Use Back Side)

Well No.

11-11-19
11-11-19
