

E16

WATER WELL DRILLERS LOG

CODED

7-9-62

Date: 7-9, 1962, Driller: P.R. Nichols, County: Neshoba

PR-8 Hugh Isaac (Name)

(1) Owner of Land: U.S. Govt (Name)

Chiles - Miss (Address)

36 11 10 (Address)

(2) Location: 1/4, 1/4, Sec. T R

7 1/2 miles West of Chiles (distance) (direction) (Nearest Town)

(3) Topography: Hilly (Hilly) (Flat) (Level)

(4) Purpose of Well: Domestic (Domestic Irrigation Municipal, Industrial, Other)

Description & Color of Materials Sand, Clay, Red Clay, Shell, etc.	Thick-ness Feet	Depth Feet
Clay & Sand	1	45
blue dirt	45	60
rock	60	90
Shell & blue dirt	90	110
rock	110	135
water sand	135	154

CODED

Information upon completion of well:

(1) Diameter 3 7/8 inches.

(2) Total Depth 158 feet.

(3) Water Level 135 feet below top of ground.

(4) Cased to Joint, Size 2"


(5) Screen: Size 2", Length 5'

(6) Were any formations sealed against pollution?  yes,  no.

If YES depth of formation 10'

Why: sanitary purposes

Drillers Remarks: Cylinder set at 140"

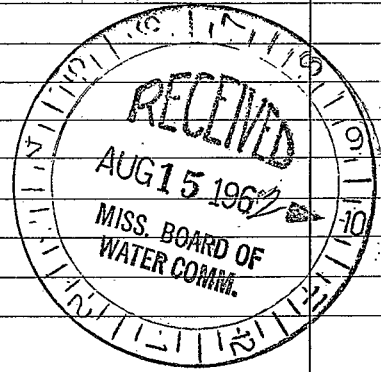

(Use Back Side)

Well No.

Handwritten notes at the top of the page, including the word "Solutions" and other illegible scribbles.

Handwritten notes in the upper middle section, appearing as a list or series of points.

Handwritten notes in the middle section, possibly a continuation of the list or a separate set of points.

Handwritten notes in the lower middle section, including some numbers and symbols.

Handwritten notes in the lower section, appearing as a list of items or a diagram.

Handwritten notes in the lower section, including some numbers and symbols.

Handwritten notes at the bottom of the page, including some numbers and symbols.