

NESHOBA

MISSISSIPPI BOARD OF WATER COMMISSIONERS

E18
7-10-62

WATER WELL DRILLERS LOG **CODED**

Date: 7-10, 1962, Driller: R.R. Nicholson County: Neshoba

RR-10 Maggie Stair (Name)

(1) Owner of Land: US Govt
Phila. Miss. (Name)
36 1110 (Address)

(2) Location: 1/4, 2 1/4, Sec. 11, T. R
7 1/4 miles west of Phila.
(Distance) (direction) (Nearest Town)

(3) Topography: Hilly
(Hilly) (Flat) (Level)

(4) Purpose of Well: Domestic
(Domestic Irrigation
Municipal, Industrial, Other)


Description & Color of Materials Sand, Clay, Red Clay, Shell, etc.	Thick- ness Feet	Depth Feet
<u>Clay & Sand</u>	<u>1</u>	<u>20</u>
<u>hilly dirt</u>	<u>20</u>	<u>32</u>
<u>rock & shell</u>	<u>32</u>	<u>110</u>
<u>blue dirt & sand</u>	<u>110</u>	<u>120</u>
<u>water sand</u>	<u>120</u>	<u>131</u>

CODED

Information upon completion of well:

- (1) Diameter 3 7/8 inches.
- (2) Total Depth 131' feet.
- (3) Water Level 105 feet below top of ground.
- (4) Cased to Point, Size 2"
- (5) Screen: Size 2", Length 5"
- (6) Were any formations sealed against pollution?
 yes, no.

If YES depth of formation 11'
Why Sanitary Purpose
Drillers Remarks: Cylinder
set at 115'

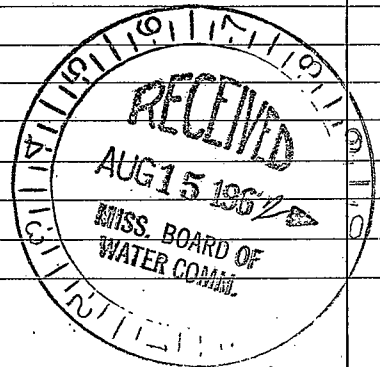

(Use Back Side)

Well No.

Handwritten notes and scribbles at the top of the page, including the number '11' and various illegible markings.

Main body of handwritten text, appearing as a list or series of notes, with some words like '11', '12', and '13' visible.