

NE3408A

E 19
9-4-62

WATER WELL DRILLERS LOG

CODED

Date: 9-4, 1962, Driller: P R Nicholas county Neshoba
PR-43 Eva B Tubley (Name)

(1) Owner of land: U S Govt - Phila miss
(Name)
(Address) 13 11 10

(2) Location: 1/4, 1/4, Sec. T R
7 1/2 miles West of Phila.
(distance) (direction) (Nearest Town)

(3) Topography: Hilly
(Hilly) (Flat) (Level)

(4) Purpose of Well: Domestic
(Domestic Irrigation
Municipal, Industrial, Other)

Description & Color of Materials Sand, Clay, Red Clay, Shell, etc.	Thick- ness Feet	Depth Feet
<u>Chalk</u>	<u>1</u>	<u>9</u>
<u>Chalky sand</u>	<u>9</u>	<u>30</u>
<u>Blue dirt</u>	<u>30</u>	<u>120</u>
<u>Sand & blue dirt</u>	<u>120</u>	<u>140</u>
<u>Water Sand</u>	<u>140</u>	<u>153</u>

CODED

Information upon completion of well:

(1) Diameter 3 7/8 inches.


(2) Total Depth 153 feet.

(3) Water Level 100 feet below top of ground.

(4) Cased to Point, Size 2"

(5) Screen: Size 2", Length 5 ft.

(6) Were any formations sealed against pollution?
 yes, no.

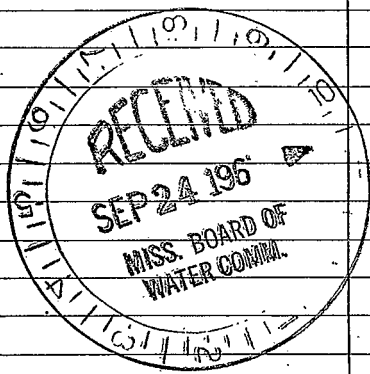

If YES depth of formation 11 ft 4" Pipe

Why Sanitary Purpose

Drillers Remarks: Cylinder set 115 ft

Well No.

(Use Back Side)

