

E20
8-17-62

WATER WELL DRILLERS LOG

CODED

Date: 8-17, 1962, Driller: R.R. Nicholson, County: Neshoba

PR-42 Wade, Billy (Name)

(1) Owner of Land: V.S. Goit.
(Name)
Phila. Miss.
(Address)
13 1110

(2) Location: 1/4, 1/4, Sec. T R
8 miles West of Phila.
(distance) (direction) (Nearest Town)

(3) Topography: Hilly (Level)


(4) Purpose of Well: Domestic
(Domestic Irrigation, Municipal, Industrial, Other)

Description & Color of Materials Sand, Clay, Red Clay, Shell, etc.	Thick- ness Feet	Depth Feet
Clay & Chalk	1	13
& Shell Chalk	13	23
Mix Chalk & Sand	23	45
Blue dirt	45	84
rock	84	88
black dirt	88	108
Blue dirt & Sand	108	130
water sand	130	141

Information upon completion of well:

- (1) Diameter 3 7/8 inches.
- (2) Total Depth 141 feet.
- (3) Water Level 100 feet below top of ground.
- (4) Cased to Point, Size 2"
- (5) Screen: Size 2", Length 5'
- (6) Were any formations sealed against pollution?
yes, no.

CODED

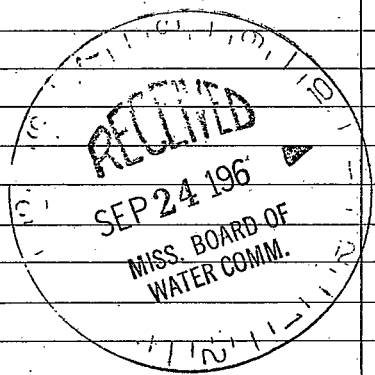

If YES depth of formation 11 ft 4" Pipe
Why Sanitary Purpose
Drillers Remarks: Cylinder
set 108 ft

(Use Back Side)

Well No.

