

E22  
9-5-62

WATER WELL DRILLERS LOG

**CODED**

Date: 9-5, 1962, Driller: R.R. Nicholson County Nebraska  
PR-40 Baxter York Name

(1) Owner of Land: U.S. Govt.  
Phila. Miss.  
(Name)  
(Address)


(2) Location: 10 11 10  
8 1/2 miles West of Phila.  
(distance) (direction) (Nearest Town)

(3) Topography: Hilly  
(Hilly) (Flat) (Level)

(4) Purpose of Well: Domestic  
(Domestic Irrigation  
Municipal, Industrial, Other)

Description & Color of Materials Sand, Clay, Red Clay, Shell, etc.	Thick- ness Feet	Depth Feet
<u>Chalk</u>	<u>1</u>	<u>5</u>
<u>Shell &amp; Chalk</u>	<u>5</u>	<u>24</u>
<u>rock</u>	<u>24</u>	<u>33</u>
<u>Chalk &amp; Sand</u>	<u>33</u>	<u>62</u>
<u>Water Sand</u>	<u>62</u>	<u>75</u>

**CODED**

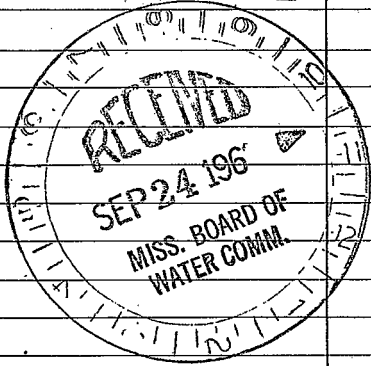

Information upon completion of well:

(1) Diameter 3 7/8 inches.

(2) Total Depth 75 feet.

(3) Water Level 60 feet below top of ground.

(4) Cased top Point, Size 2"

(5) Screen: Size 2", Length 5 ft.

(6) Were any formations sealed against pollution?  
yes, no.

If YES depth of formation 11 ft 4" pipe

Why Sanitary purpose

Drillers Remarks: Cylinder  
set 69 ft

(Use Back Side)

Well No.

