

ESH08A
E25

WATER WELL DRILLERS LOG

CODED

10-4-62

Date: 10-4, 1962, Driller: B B Nicholas, Neshoba
PR-34 LE John (Name)

(1) Owner of land: US Govt
Phila. Miss
(Name)
(Address)

(2) Location: 10 1110
10 1/2 miles West of Phila
(distance) (direction) (Nearest Town)

(3) Topography: Hilly
(Hilly) (Flat) (Level)

(4) Purpose of Well: Domestic
(Domestic Irrigation
Municipal, Industrial, Other)

Description & Color of Materials Sand, Clay, Red Clay, Shell, etc.	Thick- ness Feet	Depth Feet
<u>Chalk & Clay</u>	<u>0</u>	<u>15</u>
<u>Chalk & sand</u>	<u>15</u>	<u>25</u>
<u>Rocky</u>	<u>25</u>	<u>55</u>
<u>Blue dirt shell</u>	<u>55</u>	<u>70</u>
<u>Blue dirt sand</u>	<u>70</u>	<u>108</u>
<u>Some water sand</u>	<u>108</u>	<u>121</u>

CODED


Information upon completion of well:

- (1) Diameter 3 7/8 inches.
- (2) Total Depth 121 feet.
- (3) Water Level 85 feet below top of ground.
- (4) Cased to Joint, Size 2"
- (5) Screen: Size 2", Length 5 ft
- (6) Were any formations sealed against pollution?
2 yes, no.

If YES depth of formation 10 ft 4" Pipe

Why Sanitary Purpose

Drillers Remarks: Cylinder
Set at 102 ft

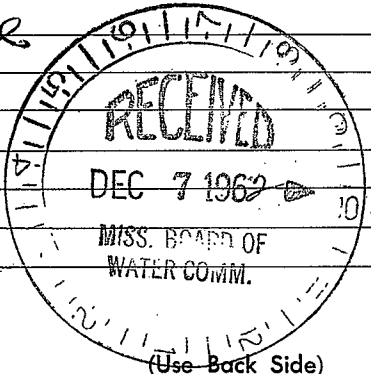

Well No.

Handwritten notes at the top of the page, including the date "1944" and several lines of illegible text.

Handwritten word, possibly "Summary".

Handwritten notes in the middle section, including the word "The" and other illegible text.

Handwritten notes at the bottom of the page, including the date "1944" and the phrase "copy of the report".